

Granville - Vance District Health Department
Environmental Health


Final Sketch

Pin 0539 02006

Subdivision - Section - Lot

Physical Address: 700 Southerland Mill Rd

System design and details as installed.

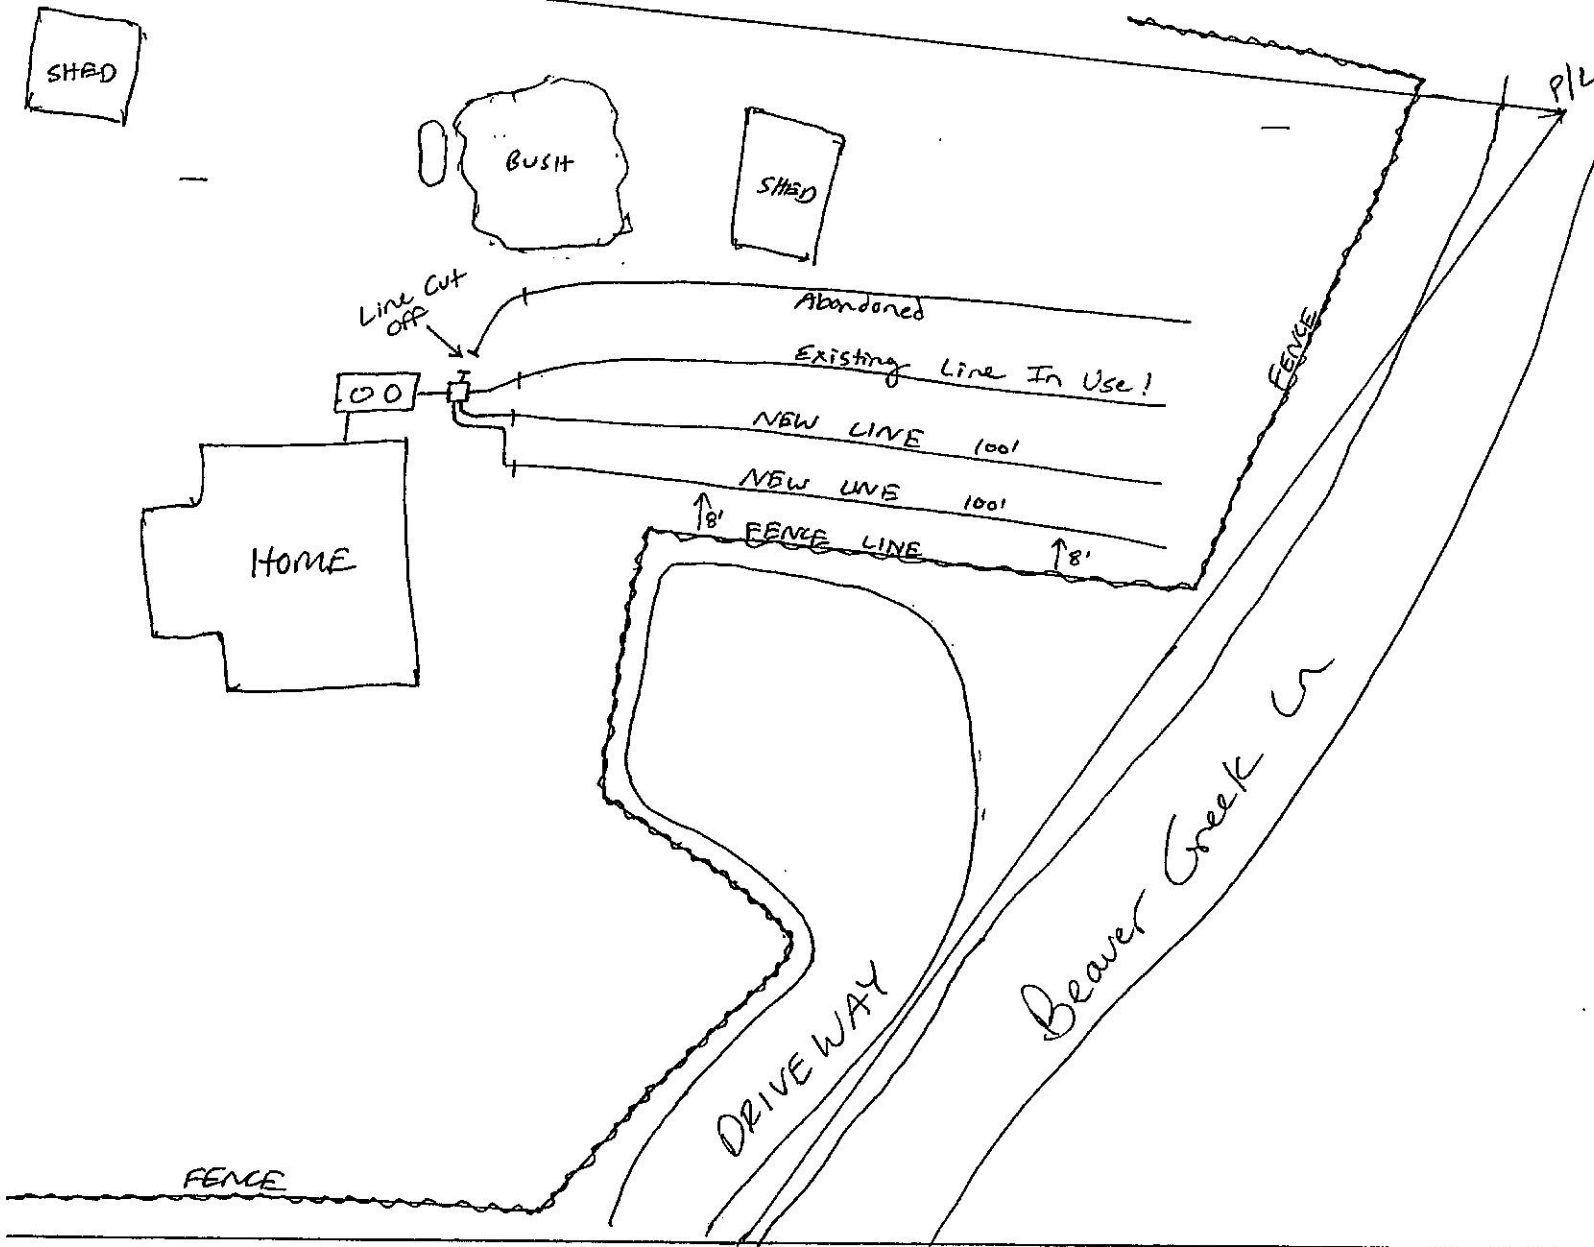

Southerland Mill Road

[Signature]
Authorized Signature

8/3/2020
Date