

GRANVILLE-VANCE HEALTH DISTRICT

No. 11:30
2821

(Septic Tank) Improvements Permit & Certificate of Completion

Owner or Contractor Edward R. Vics Date 2-12-92 S.R. No. _____


Location/Address US 41 R-2955 Summer Lake

Subdivision/Mobile Home Park Name _____ Lot Size 10.6 ac
Lot No. _____

New System ☒ Repair _____
House _____ Mobile Home ☒ Business _____
No. Bedrooms 3 No. People 2 No. Toilets 2
Water Supply: Private _____ Approved _____
Semi-Public _____ Unapproved _____
Public ☒ None _____

Nitrification System:
Tank Size 1000 gal.
Distribution Box 495 No. Lines 3
Nitrification Field 1200 Sq. Ft.
Lines: 1 2 3 4 5 6
Width 3 3 3 _____
Length 133 133 133 _____
Grade _____
Stone Depth 12 12 12 _____

Layout to be followed by installer:

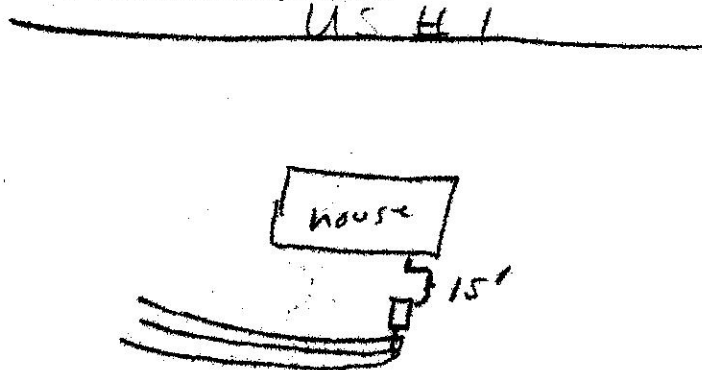

Improvements Permit By W. Haugh Installer R. B. Thanning
Certificate of Completion By J. P. Kelly Date of Inspection 4-6-92

* Construction must comply with all other applicable state and local regulations, but the permit is not a guarantee that the system will not malfunction and the Granville-Vance Health District will not be held responsible for a malfunctioning system.