

Granville - Vance District Health Department

Environmental Health

1475

Well Construction Permit

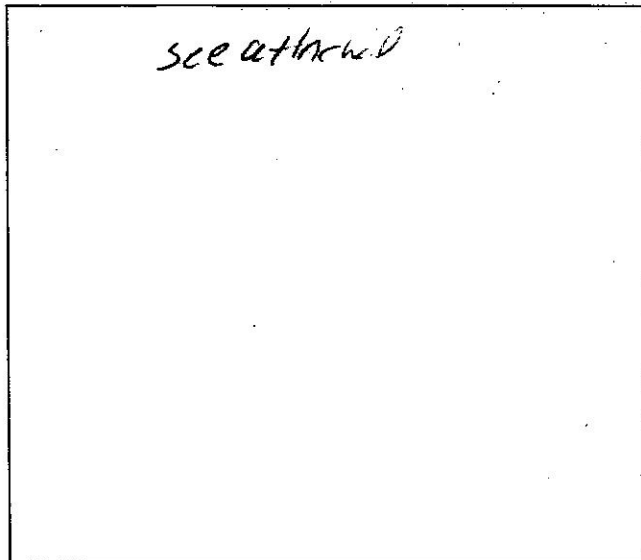
m-7-648

Owner/Applicant: Michael J. Donoghue Date: 9/15/16
Address or Location of Property: 1428 Spring Valley Lake Rd, Henderson
0202 01037
Subdivision & Lot #: _____ Septic Permit #: 8577
Zoning Permit #: _____ Environmental Health Specialist: CAIT

This well permit is to locate and site the area that a private groundwater well may be established on the property listed above by the Environmental Health Specialists of Granville County. If one does not locate the well in the approved area and complete the well as specified by the 15A NCAC .02C rules, then permits may be revoked. At completion of drilling of the well, grout must be witnessed by EHS and a well log turned into Environmental Health.

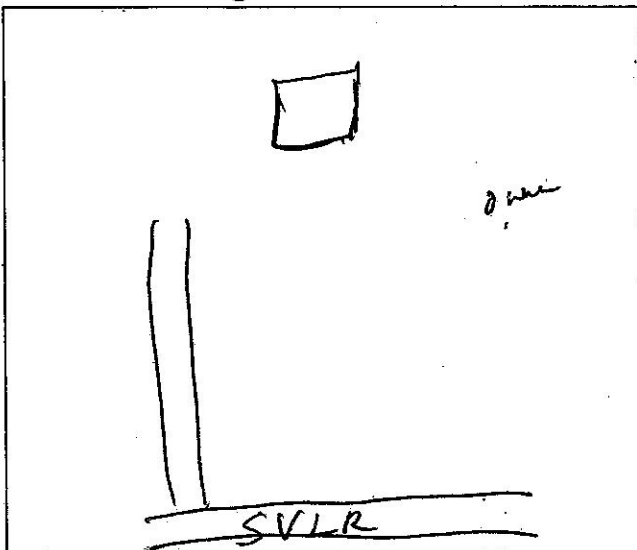
Minimum Setbacks: (these are the main setbacks, but not all required setbacks)

Setback from property lines - 10 ft Setback from septic tank and drain field, including repair area - 100 ft
Setback from structural foundations - 25 ft Setback from ponds, lakes or other bodies of water - 50 ft

Site Sketch:**Conditions:**

Authorized Agent: Chi Hall
Date: 9/15/16

1 Well Grout: (Circle or write in)
Witnessed: Yes or No EHS Agent: Chi Hall
Date: 7/10/17 Annular Space Open: Yes or No
Over reamed: Yes or No Depth Grouted: 20' +
Method: _____ Pump ✓ Poured _____ Pressure
Well Log received: Yes or No (EHS to Attach to Permit)
Driller Name: Jerry Ball Cert. # 2476
Depth: 220 Casing Depth: 35 GPM: 5

As Built Drawing:**# 2 Well Final: (Place a check mark when finalized)**

Seal Present and Intact: ✓ Air Vent: ✓
Hose Spigot: ✓ Electrical Box: ✓
Pump Installer Tag: ✓ Well Installer Tag: ✓
All holes sealed: ✓ 12" above grade: ✓
Comments: _____

3 Well Completion Permit: Chi Hall EHS
Date Completed: 6/24/18

4 Water Samples Taken: Date: 6-26-18
EHS: Chris Hedrick Results: _____
Retest: _____ Results: _____