


GRANVILLE-VANCE HEALTH DEPARTMENT—Sewage Disposal Record

Owner or Contractor Keeter, Charles III Date 9-16-91 S.R. No. _____
 Location/Address Epsom left 24 mi on left (off Rd)
 Subdivision/Mobile Home Park Name _____ Lot Size 3.0m
 Permit No. # _____ Lot No. _____

New System ☒ Repair _____
 House ☒ Mobile Home _____ Business _____
 No. Bedrooms 3 No. People 3 No. Toilets 1
 Water Supply: Private ☒ Approved _____
 Semi-Public _____ Unapproved _____
 Public _____ None _____

Nitrification System:
 Tank Size 1000 gal.
 Distribution Box yes No. Lines 3
 Nitrification Field 900 Sq. Ft.
 Lines: 1 2 3 4 5 6
 Width 3 3 3 _____ _____ _____
 Length 100 100 100 _____ _____ _____
 Grade 1 1 1 _____ _____ _____
 Stone Depth 12 12 12 _____ _____ _____

Layout to be followed by installer:

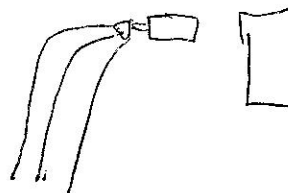

Improvements Permit By W. Vaughn Installer Tom Howell
 Certificate of Completion By W. Vaughn Date of Inspection 1-21-92

* Construction must comply with all other applicable state and local regulations, but the permit is not a guarantee that the system will not malfunction and the Granville-Vance Health District will not be held responsible for a malfunctioning system.