

* Pumping System (offsite)

1.30

PERMIT NUMBER 06410

GRANVILLE-VANCE DISTRICT HEALTH DEPARTMENT
IMPROVEMENT AND OPERATION PERMITS

COUNTY:	TAX NO.	TYPE OF ESTABLISHMENTS			*THIS PERMIT SHALL BE ACCOMPANIED BY A LAYOUT SHOWN ON A PLAT, INCLUDING SYSTEM REQUIREMENTS.
Vance	0372301032	RESIDENCE ☒	NUMBER OF BEDROOMS:	NUMBER OF OCCUPANTS:	
OWNER: J-Wel + Assoc.	SR. NO. 0372301032	BUSINESS ☐	3	≤6	
APPLICANT'S ADDRESS:		OTHER ☐	WELL ☒	OTHER ☐	
		WATER SUPPLY	PUBLIC ☐		
		TYPE OF WASTEWATER SYSTEM	INITIAL Type III INSTALLATION	Pump to Conventional	Pump REPAIR Accepted 25% Reduction
PROPERTY ADDRESS/LOCATION:		DESIGN FLOW:	360 g/day		
801 Port Dr.		LTAR:	3		
SUBDIVISION:		ABSORPTION AREA:	1,000 sq ft		
Salesboro Plantation		TRENCH WIDTH:	3'		
LOT NUMBER: 32		TRENCH DEPTH:	18' 32" out		
REFERENCE SKETCH (SEE PLAT FOR DETAILS)		TRENCH SPACING:	9' centers		
		TOTAL TRENCH LENGTH:	400' 30ft acc'd out		
		NUMBER OF TRENCHES:			
		GRAVEL DEPTH:	12" max over		
		TANK SIZE:	1,000 g		
		PUMP TANK SIZE:	1,000 g		
		DISTRIBUTION DEVICE:	Pressure Manifold		

*THIS IMPROVEMENT PERMIT IS SUBJECT TO REVOCATION IF THE INTENDED USES CHANGE FROM THOSE SHOWN ON THE IMPROVEMENT PERMIT. CHANGES SHALL REQUIRE HEALTH DEPARTMENT APPROVAL.

PERMIT VALID FOR: 5 YEARS
YES NO

NO EXPIRATION
YES NO

IMPROVEMENT PERMIT

DATE:

FOR:

ISSUED BY:

Mac Shingleton, R.S.

4-30-10

CONSTRUCTION AUTHORIZATION FOR IMPROVEMENT PERMIT# 6410

Unless otherwise indicated, the same conditions above apply regarding system type, layout, location and installation requirements.
(The wastewater system cannot be installed until authorization is signed)

Comments:

Date:

7/29/13

Environmental Health Specialist:

Ch. H. H. H.

(See attached)

Construction Authorization Addendum

☒ Yes ☐ No

OPERATION PERMIT

DATE: 9/19/13


SYSTEM INSTALLED BY:

Ernie Preece

ISSUED BY:

Ch. H. H. H.

PERFORMANCE, MONITORING, MAINTENANCE AND OPERATION
AS REQUIRED BY RULE .1961

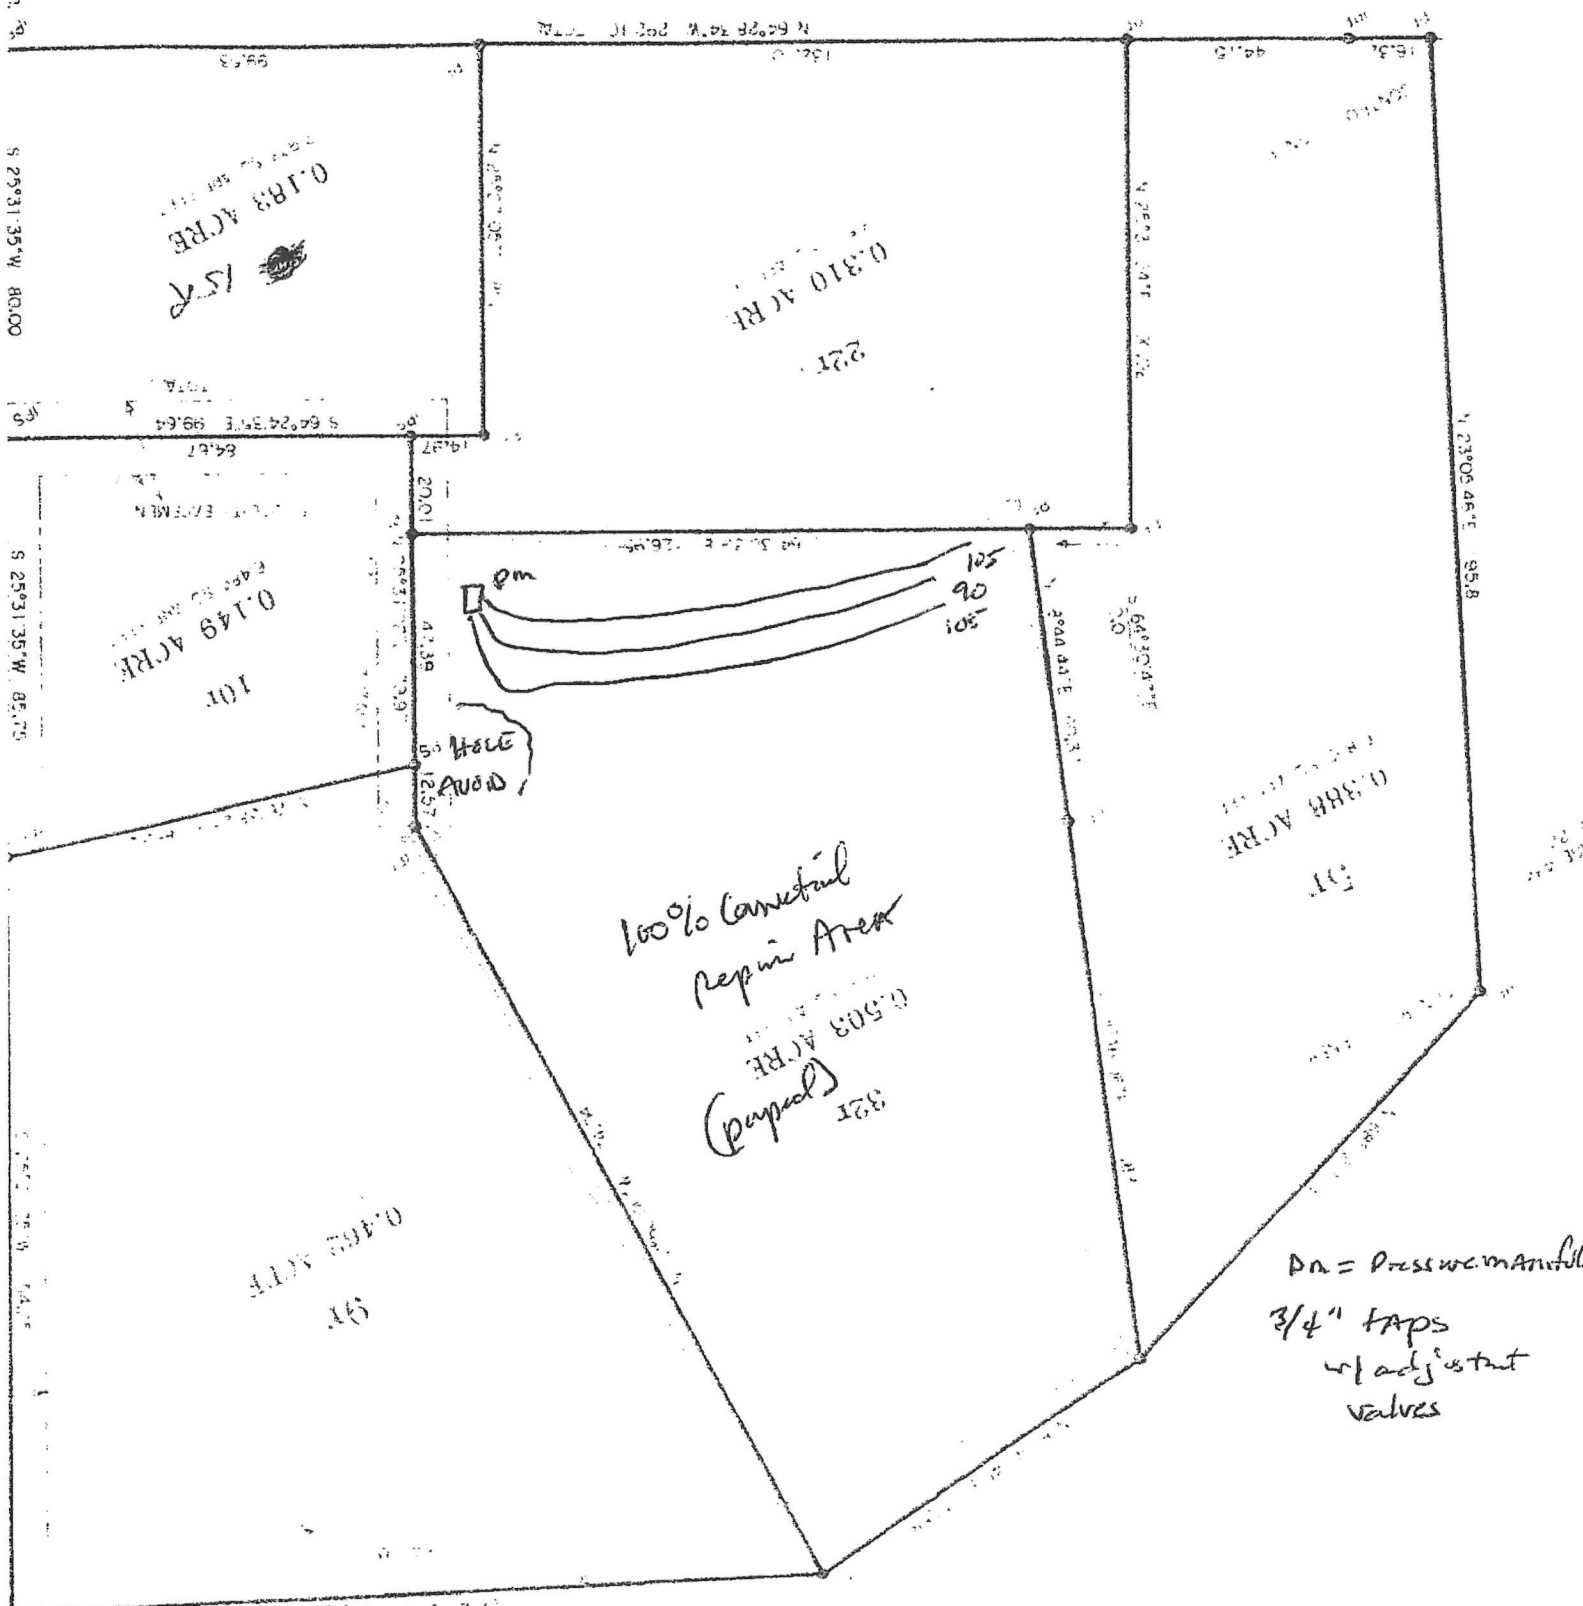

S 25°31'35"W 80.00

S 25°31'35"W 85.75

S 25°31'35"W 74.75

S 25°31'35"W 80.00

S 25°31'35"W 80.00

0.183 ACRE
15x

0.310 ACRE
22x

0.149 ACRE
10x

100% Cornfield
Repair Area
0.508 ACRE
(paved)
32x

0.888 ACRE
51x

0.402 ACRE
9x

PM = Pressure manifold
3/4" taps
w/ adjust valves

W

POND

ROAD