

Granville - Vance District Health Department

Environmental Health

Well Construction Permit


Owner/Applicant: Ron Greger Date: 6/14/13
 Address or Location of Property: 801 Port Dr. Charleston SC 29405
 Subdivision & Lot #: Lakeside Plantation 62 Septic Permit #: 6470
 Zoning Permit #: 0687 Environmental Health Specialist: MRS

This well permit is to locate and site the area that a private groundwater well may be established on the property listed above by the Environmental Health Specialists of Granville County. If one does not locate the well in the approved area and complete the well as specified by the 15A NCAC .02C rules, then permits may be revoked. At completion of drilling of the well, grout must be witnessed by EHS and a well log turned into Environmental Health.

Minimum Setbacks: (these are the main setbacks, but not all required setbacks)

Setback from property lines – 10 ft Setback from septic tank and drain field, including repair area – 100 ft
 Setback from structural foundations – 25 ft Setback from ponds, lakes or other bodies of water – 50 ft

Site Sketch:

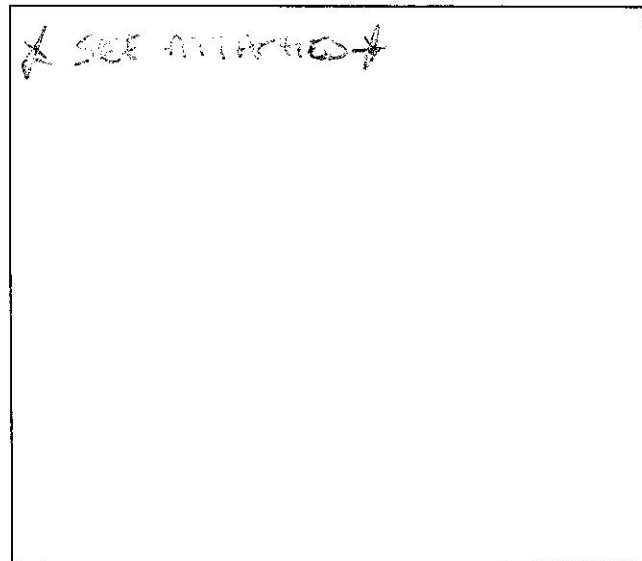

Conditions:


Authorized Agent: Chris Hall

Date: 6/14/13

1 Well Grout: (Circle or write in)

Witnessed: Yes or No EHS Agent: Chris Hall
 Date: 6/22/13 Annular Space Open: Yes or No
 Over reamed: Yes or No Depth Grouted: 20' +
 Method: Pump ✓ Poured _____ Pressure _____
 Well Log received Yes or No (EHS to Attach to Permit)
 Driller Name: Jerry Ball Cert. # 2476
 Depth: 220 Casing Depth: 56' GPM: 5

As Built Drawing:

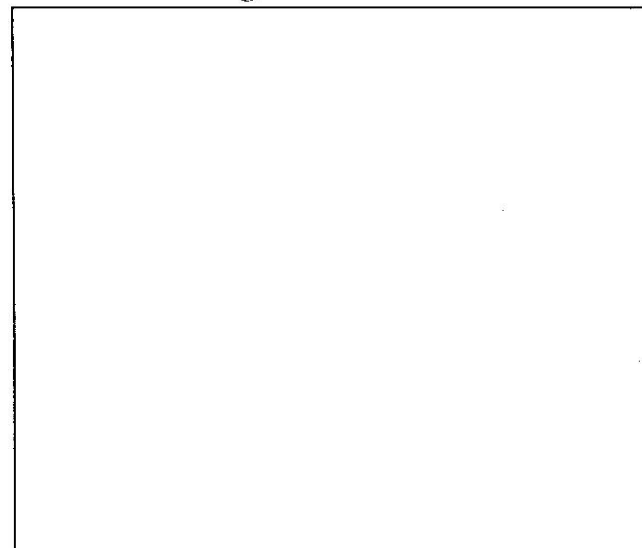

2 Well Final: (Place a check mark when finalized)

Seal Present and Intact: ✓ Air Vent: ✓
 Hose Spigot: ✓ Electrical Box: ✓
 Pump Installer Tag: ✓ Well Installer Tag: ✓
 All holes sealed: ✓ 12" above grade: ✓
 Comments: _____

3 Well Completion Permit: Chris Hall EHS

Date Completed: 9/30/13

4 Water Samples Taken: Date: _____

EHS: _____ Results: _____
 Retest: _____ Results: _____