

(Septic Tank) Improvements Permit and Certificate of Completion

Owner or Contractor Tommy Mc Lee Date 5-6-75 S.R. No. 1351

Location 110 Williams Ave

Subdivision Name _____ Lot No. _____ Section or Block No. _____

New System ☒ Repairs ☐
 House ☐ Mobile Home ☒ Business ☐
 No. Bedrooms 2 No. In Family 3
 No. Bathrooms _____
 Garbage Disposal Yes ☐ No ☒
 Auto. Dishwasher Yes ☐ No ☒
 Auto. Wash. Machine Yes ☐ No ☒
 Water Supply: Individual ☒ Public ☐
 Nitrification System: Tank Size 1000 Gal.
 Distribution Box Yes

Nitrification Field 510 Sq. ft.
 Nitrification Lines: 170 Length
3 Width _____ No. _____
 Lot: area 6800 length _____ width _____
Keep 20' uphill from pond.
6' ditch is acceptable if
two lines in ditch.


Improvements Permit By See Notice Installed By Fred Williamson

Certificate of Completion By DW Date 6-4-75

* Construction must comply with all other applicable state and local regulations, but the permit is not a guarantee that the system will not malfunction and the Granville-Vance Health District will not be held responsible for a malfunctioning system.

DW info
was for septic permit
a single 1945
under 2-13R
and DW title
no info available on
the well

CONFIDENTIAL

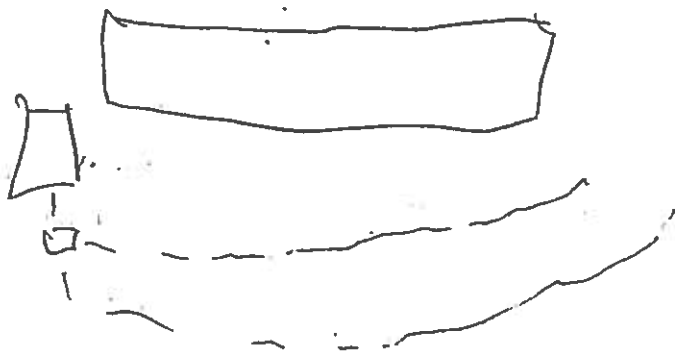

FEB 20 1990

✓ 3911-506328

FORM MVR-191

STATE OF NORTH CAROLINA



Department of Transportation Division of Motor Vehicles

Certificate of Title of a Motor Vehicle



The Commissioner of Motor Vehicles of the State of North Carolina hereby certifies that an application for a Certificate of Title to the herein described vehicle has been filed pursuant to the General Statutes of North Carolina

1984 YEAR MODEL	CONN MAKE	MH BODY STYLE	CHCCNC442411933JS4936A VEHICLE IDENTIFICATION NUMBER	
02/16/90 TITLE ISSUE DATE	CODE	GROSS WEIGHT	LICENSE FEE	1004512782B TITLE NUMBER

Codes: R—Rebuilt or Reconstructed; M—Motor Change; B—Body Change

FRANK THOMAS MCGHEE, SR
 SARA WILLIAMS MCGHEE
 905 CARROLL RD
 HENDERSON, N.C.

27536

And that the applicant has stated under oath that said applicant is the owner of said motor vehicle and that it is subject to the following liens and none other.

Third Lien	LIENHOLDER	DATE	THIRD LIEN RELEASED	DATE
Second Lien	LIENHOLDER	DATE	SECOND LIEN RELEASED	DATE
	LIENHOLDER	DATE	SECOND LIEN RELEASED	DATE
First Lien	LIENHOLDER	DATE	FIRST LIEN RELEASED	DATE
	NCNB 39 PO BOX 23500 GREENSBORO, N.C.	02/07/90	NCNB NATIONAL BANK	FEB 27 1990

ADDITIONAL LIENS:

He does further certify that reasonable diligence has been used in ascertaining whether or not the facts in said application for a certificate of title are true, and he is satisfied that the applicant is the lawful owner of the above described vehicle or is otherwise entitled to have the same registered in his name. Therefore, he does hereby certify that the above named applicant has been duly registered in the office of the Division of Motor Vehicles as the lawful owner of the above described vehicle, or is otherwise entitled to have the same registered in his name, and that it appears upon the official records of the Division of Motor Vehicles that at the date of the issuance of this certificate, said vehicle is subject to the liens hereinbefore enumerated, if any, and none other.

As WITNESS, his hand and seal of this Division the day and year appearing in this certificate as the title issue date.

39492156

William S. Hiatt

COMMISSIONER OF MOTOR VEHICLES

UNIT -1 LC14