


PERMIT NUMBER 2751

**GRANVILLE - VANCE DISTRICT HEALTH DEPARTMENT
IMPROVEMENT AND OPERATION PERMITS**

Billy J. Grimsley

COUNTY: Vance	TAX NO.	TYPE OF ESTABLISHMENT			*THIS PERMIT SHALL BE ACCOMPANIED BY A LAYOUT SHOWN ON A PLAT, INCLUDING SYSTEM REQUIREMENTS. *THE IMPROVEMENTS PERMIT MUST BE ATTACHED TO A CONSTRUCTION AUTHORIZATION BEFORE OBTAINING BUILDING PERMIT OR OTHER CONSTRUCTION PERMITS AND BEFORE A WASTEWATER SYSTEM IS INSTALLED. *THIS IMPROVEMENT PERMIT IS SUBJECT TO REVOCATION IF THE INTENDED USE CHANGE FROM THOSE SHOWN ON THE IMPROVEMENT PERMIT. CHANGES SHALL REQUIRE HEALTH DEPARTMENT APPROVAL.																							
	SER NO. 1309	RESIDENCE ☒ BUSINESS ☐ OTHER ☐	NUMBER OF BEDROOMS: 3	NUMBER OF OCCUPANTS: 2																								
OWNER: Charles Bowman																												
APPLICANT: Scum		WATER SUPPLY																										
APPLICANT'S ADDRESS: 0209A02005		PUBLIC ☐	WELL ☒	OTHER ☐																								
PROPERTY ADDRESS/LOCATION:		TYPE OF WASTEWATER SYSTEM																										
153 Cedar Grove Dr. SUBDIVISION: Cedar Grove LOT NUMBER: 2		DESCRIPTION	INITIAL INSTALLATION	REPAIR																								
		DESIGN FLOW: 1.360																										
		LTAR: .25																										
REFERENCE SKETCH (SEE PLAT FOR DETAILS) 		ABSORPTION AREA: 1500²ft																										
		TRENCH WIDTH: 3																										
		TRENCH SPACING: 9'																										
		TOTAL TRENCH LENGTH: 500'																										
		NUMBER OF TRENCHES: 4 or 5																										
		GRAVEL DEPTH: 12"																										
		TANK SIZE: 1000																										
CONDITIONS:																												
<table border="1"> <tr> <td colspan="3">IMPROVEMENT PERMIT</td> <td>DATE:</td> </tr> <tr> <td>FOR:</td> <td colspan="2"></td> <td></td> </tr> <tr> <td>ISSUED BY:</td> <td>Walter T Vaughn RS</td> <td></td> <td>10-26-2000</td> </tr> <tr> <td colspan="3">OPERATION PERMIT</td> <td>DATE:</td> </tr> <tr> <td>SYSTEM INSTALLED BY:</td> <td colspan="2">Simmons Const</td> <td></td> </tr> <tr> <td>ISSUED BY:</td> <td>W. Vaughn</td> <td></td> <td>3-16-2001</td> </tr> </table>					IMPROVEMENT PERMIT			DATE:	FOR:				ISSUED BY:	Walter T Vaughn RS		10-26-2000	OPERATION PERMIT			DATE:	SYSTEM INSTALLED BY:	Simmons Const			ISSUED BY:	W. Vaughn		3-16-2001
IMPROVEMENT PERMIT			DATE:																									
FOR:																												
ISSUED BY:	Walter T Vaughn RS		10-26-2000																									
OPERATION PERMIT			DATE:																									
SYSTEM INSTALLED BY:	Simmons Const																											
ISSUED BY:	W. Vaughn		3-16-2001																									

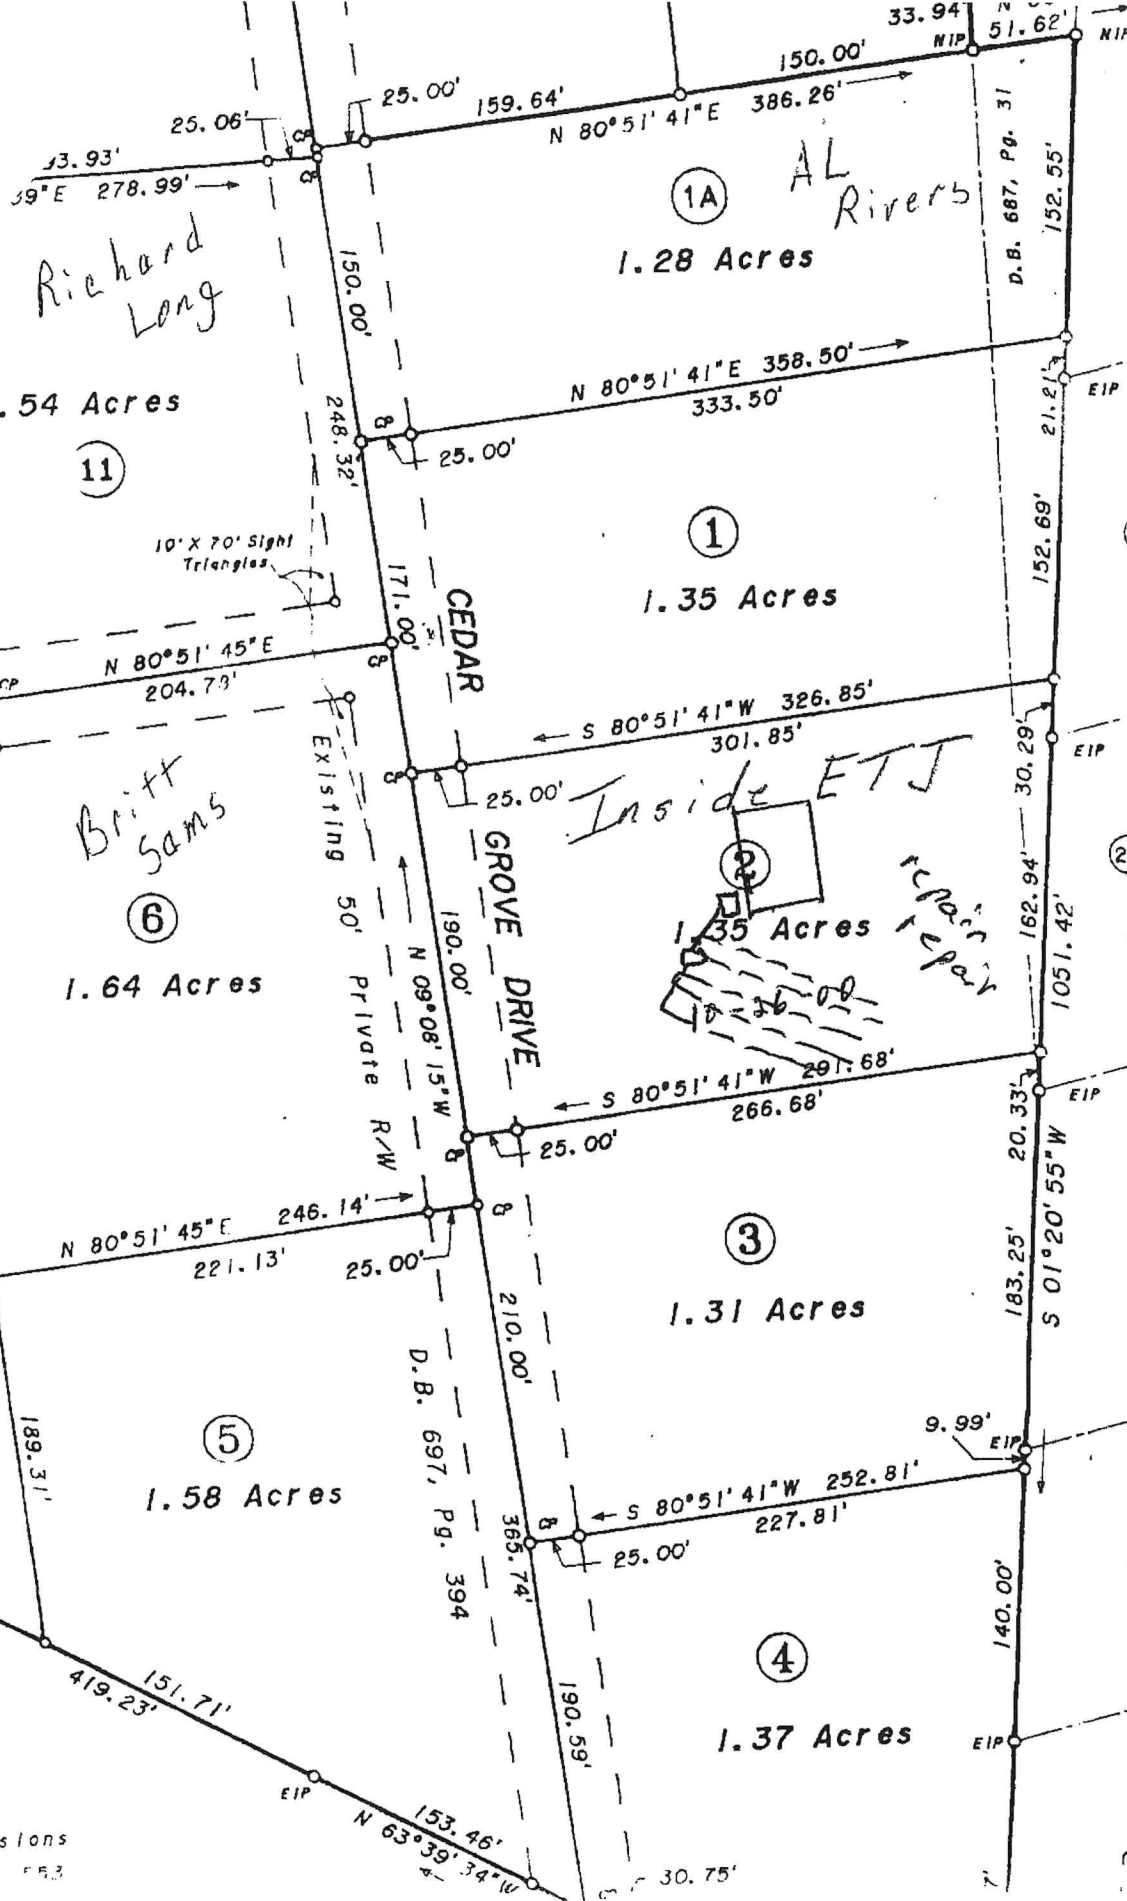

David A. Kearney
D.B. 56, Pg. 46
P.B. "T", Pg. 96
(22)

Alvin T. Jaught
D.B. 680, Pg.
P.B. "T", Pg.
(23)

James M. Wheeler, Jr.
D.B. 512, Pg. 7
P.B. "T", Pg. 9
(24)

Howell A. O'Gear
D.B. 591, Pg. 26
P.B. "T", Pg. 9
(25)

G. Anthony Norwood
D.B. 548, Pg. 535
P.B. "T", Pg. 996
(26)

Gerald P. Fuller
D.B. 513, Pg. 657
P.B. "T", Pg. 996
(27)

J. Sessions
Pg. 53