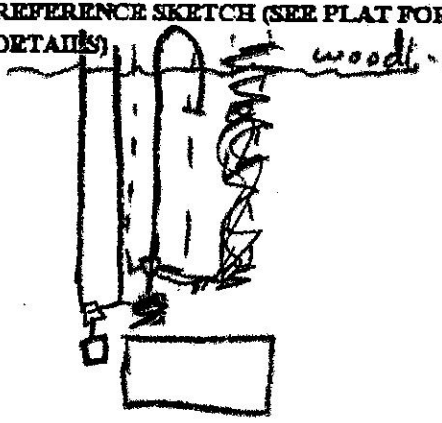


3:00

PERMIT NUMBER 42 1961

**GRANVILLE - VANCE DISTRICT HEALTH DEPARTMENT
IMPROVEMENT AND OPERATION PERMITS**

COUNTY: <i>Vance</i>	TAX NO. <i>0365 D01013</i>	TYPE OF ESTABLISHMENT			*THIS PERMIT SHALL BE ACCOMPANIED BY A LAYOUT SHOWN ON A PLAT, INCLUDING SYSTEM REQUIREMENTS. *THE IMPROVEMENTS PERMIT MUST BE ATTACHED TO A CONSTRUCTION AUTHORIZATION BEFORE OBTAINING BUILDING PERMIT OR OTHER CONSTRUCTION PERMITS AND BEFORE A WASTEWATER SYSTEM IS INSTALLED. *THIS IMPROVEMENT PERMIT IS SUBJECT TO REVOCATION IF THE INTENDED USE CHANGE FROM THOSE SHOWN ON THE IMPROVEMENT PERMIT. CHANGES SHALL REQUIRE HEALTH DEPARTMENT APPROVAL.
	SER. NO. <i>1329</i>	RESIDENCE ☒ BUSINESS ☐ OTHER ☐	NUMBER OF BEDROOMS: <i>3</i>	NUMBER OF OCCUPANTS: <i>—</i>	
OWNER: <i>Creative</i>					
APPLICANT: <i>same</i>		WATER SUPPLY			
APPLICANT'S ADDRESS:		PUBLIC ☐	WELL ☒	OTHER ☐	
PROPERTY ADDRESS/LOCATION: <i>Thomas Rd</i> <i>2</i> <i>48 Canary Lane</i>		TYPE OF WASTEWATER SYSTEM			
SUBDIVISION: <i>Key Est</i>		DESCRIPTION	INITIAL INSTALLATION	REPAIR	
LOT NUMBER: <i>37</i>		DESIGN FLOW:	<i>360</i>		
		LTAR:	<i>.3</i>		
REFERENCE SKETCH (SEE PLAT FOR DETAILS)		ABSORPTION AREA:	<i>1200²ft</i>		
		TRENCH WIDTH:	<i>3</i>		
		TRENCH SPACING:	<i>9'</i>		
		TOTAL TRENCH LENGTH:	<i>400'</i>		
		NUMBER OF TRENCHES:	<i>5</i>		
		GRAVEL DEPTH:	<i>18"</i>		
		TANK SIZE:	<i>1000</i>		
		CONDITIONS:	<i>more clearing needed</i>		
IMPROVEMENT PERMIT				DATE:	
FOR:					
ISSUED BY: <i>Wallen T. Vaughn ES</i>				<i>6-29-99</i>	
OPERATION PERMIT				DATE:	
SYSTEM INSTALLED BY: <i>Wayne Ayseue</i>					
ISSUED BY: <i>W. Vaughn</i>				<i>8-2-99</i>	