


Lunch... for Cole... Feb 2nd

PERMIT NUMBER NO 0994

GRANVILLE - VANCE DISTRICT HEALTH DEPARTMENT IMPROVEMENT AND OPERATION PERMITS

COUNTY: Vance	TAX NO. SR NO. 1549	TYPE OF ESTABLISHMENT			*THIS PERMIT SHALL BE ACCOMPANIED BY A LAYOUT SHOWN ON A PLAT, INCLUDING SYSTEM REQUIREMENTS. *THE IMPROVEMENTS PERMIT MUST BE ATTACHED TO A CONSTRUCTION AUTHORIZATION BEFORE OBTAINING BUILDING PERMIT OR OTHER CONSTRUCTION PERMITS AND BEFORE A WASTEWATER SYSTEM IS INSTALLED. *THIS IMPROVEMENT PERMIT IS SUBJECT TO REVOCATION IF THE INTENDED USE CHANGE FROM THOSE SHOWN ON THE IMPROVEMENT PERMIT. CHANGES SHALL REQUIRE HEALTH DEPARTMENT APPROVAL.
OWNER: Energy Efficient		RESIDENCE ☒ BUSINESS ☐ OTHER ☐	NUMBER OF BEDROOMS: 4	NUMBER OF OCCUPANTS: 3	
APPLICANT: Anthony Dickerson		WATER SUPPLY			
APPLICANT'S ADDRESS: 1233 Bobb Rd		PUBLIC ☐	WELL ☒	OTHER ☐	
PROPERTY ADDRESS/LOCATION: 402 Buffalo Creek Lane		TYPE OF WASTEWATER SYSTEM			
		DESCRIPTION	INITIAL INSTALLATION ☒	REPAIR	
SUBDIVISION: Buffalo Creek		DESIGN FLOW: 480 gal/day			
LOT NUMBER: 14 R		LTAR: .4			
REFERENCE SKETCH (SEE PLAT FOR DETAILS) See sketch attached. Dig trenches 12'-24" deep (small) on contour (dig at least 3' from house, 12' from property line, + 100' from any well. Do not install or cut for inspection in rain.		ABSORPTION AREA: 1200 sq. ft.			
		TRENCH WIDTH: 3'			
		TRENCH SPACING: 9' on center			
		TOTAL TRENCH LENGTH: 400 ft.			
		NUMBER OF TRENCHES: 3 or 4			
		GRAVEL DEPTH: 12"			
		TANK SIZE: 1000 gal			
		CONDITIONS:			
IMPROVEMENT PERMIT			DATE: 12-11-97		
FOR: Anthony Dickerson ISSUED BY: [Signature]					
OPERATION PERMIT			DATE: 1-2-98		
SYSTEM INSTALLED BY: Cole's Backhoe Service ISSUED BY: [Signature]					

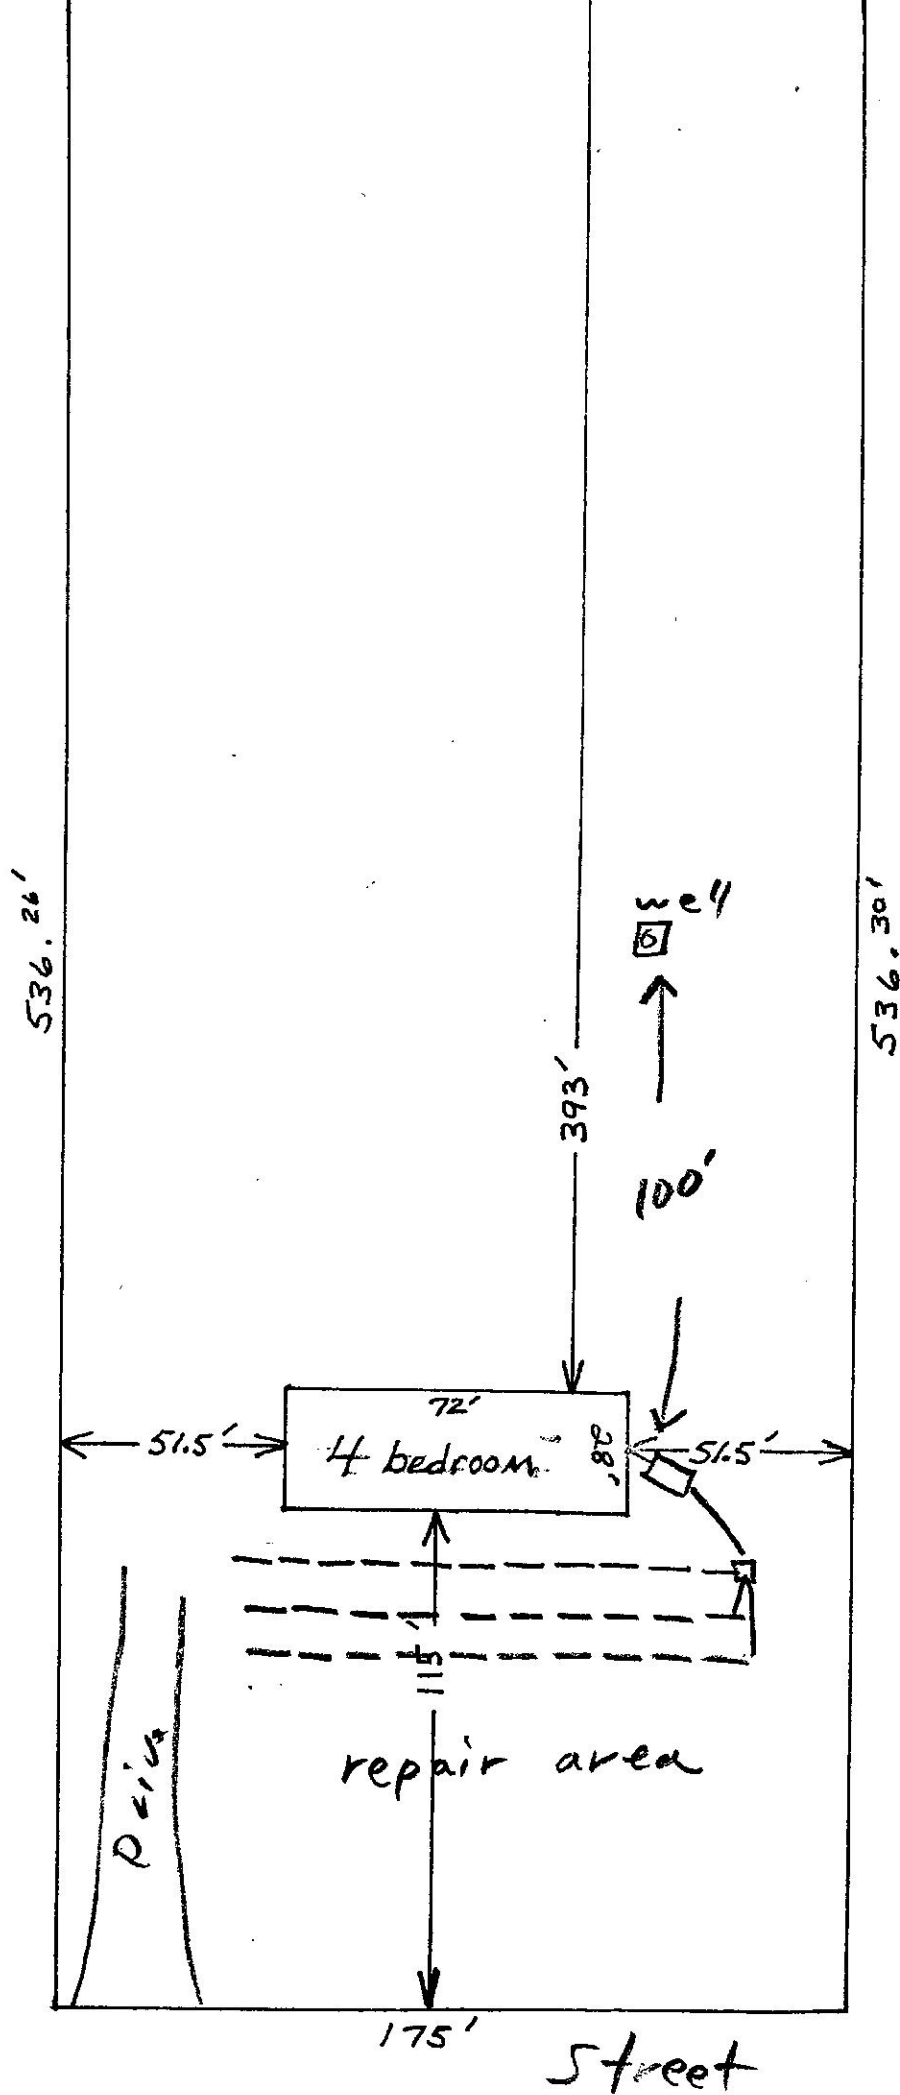

Bobbitt Rd.
→