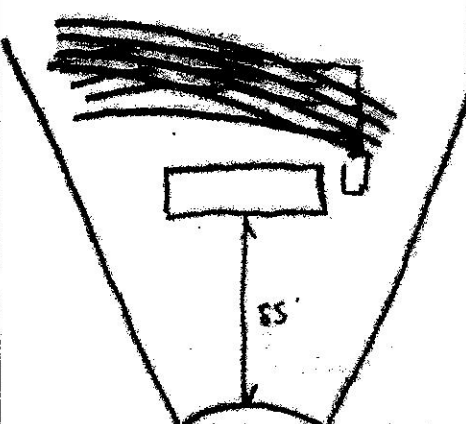


PERMIT NUMBER **2765**

**GRANVILLE - VANCE DISTRICT HEALTH DEPARTMENT
IMPROVEMENT AND OPERATION PERMITS**

COUNTY: VANCE	TAX NO. 6461602059	TYPE OF ESTABLISHMENT			*THIS PERMIT SHALL BE ACCOMPANIED BY A LAYOUT SHOWN ON A PLAT, INCLUDING SYSTEM REQUIREMENTS. *THE IMPROVEMENTS PERMIT MUST BE ATTACHED TO A CONSTRUCTION AUTHORIZATION BEFORE OBTAINING BUILDING PERMIT OR OTHER CONSTRUCTION PERMITS AND BEFORE A WASTEWATER SYSTEM IS INSTALLED. *THIS IMPROVEMENT PERMIT IS SUBJECT TO REVOCATION IF THE INTENDED USE CHANGE FROM THOSE SHOWN ON THE IMPROVEMENT PERMIT. CHANGES SHALL REQUIRE HEALTH DEPARTMENT APPROVAL.
	SR NO.	RESIDENCE ☒ X BUSINESS ☐ OTHER ☐	NUMBER OF BEDROOMS: ON 4 3	NUMBER OF OCCUPANTS: ON 48 6	
OWNER: HOMEROYS					
APPLICANT: TIM BRIDGES		WATER SUPPLY			
APPLICANT'S ADDRESS:		PUBLIC ☐	WELL ☒ X	OTHER ☐	
PROPERTY ADDRESS/LOCATION: MARIGOLD LN. 324		TYPE OF WASTEWATER SYSTEM			
SUBDIVISION: SPRING FOREST III		DESCRIPTION	INITIAL INSTALLATION	REPAIR	
LOT NUMBER: 127		DESIGN FLOW:	3.5 GPM 1.5 GPM		
REFERENCE SKETCH (SEE PLAT FOR DETAILS) 		LTAR:	0.3		
		ABSORPTION AREA:	1200 FT² 1600 FT²		
		TRENCH WIDTH:	3'		
		TRENCH SPACING:	9' ON CENTERS		
		TOTAL TRENCH LENGTH:	400' 534'		
		NUMBER OF TRENCHES:	3-5		
		GRAVEL DEPTH:	12"		
		TANK SIZE:	1010 GAL		
		CONDITIONS:	24" TRENCH DEPTH		
IMPROVEMENT PERMIT				DATE:	
FOR: HOMEROYS ISSUED BY: Paul I. Henderson				11-3-00	
OPERATION PERMIT				DATE:	
SYSTEM INSTALLED BY: Tom Henderson ISSUED BY: Paul I. Henderson				8-24-01	