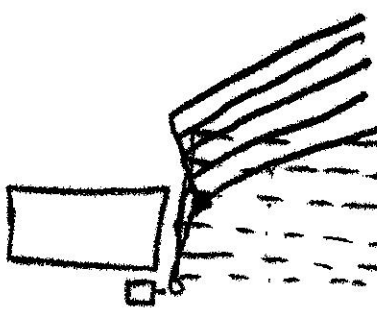


3:00 PM

PERMIT NUMBER 2481

**GRANVILLE - VANCE DISTRICT HEALTH DEPARTMENT
IMPROVEMENT AND OPERATION PERMITS**

COUNTY: Vance	TAX NO. 0539 A01030	TYPE OF ESTABLISHMENT			*THIS PERMIT SHALL BE ACCOMPANIED BY A LAYOUT SHOWN ON A PLAT, INCLUDING SYSTEM REQUIREMENTS.
	SR NO. 1523	RESIDENCE ☒ BUSINESS ☐ OTHER ☐	NUMBER OF BEDROOMS: 4	NUMBER OF OCCUPANTS: 2	
OWNER: Charlie Williams					
APPLICANT: Ventures		WATER SUPPLY			
APPLICANT'S ADDRESS:		PUBLIC ☐	WELL ☐	OTHER ☐	*THE IMPROVEMENTS PERMIT MUST BE ATTACHED TO A CONSTRUCTION AUTHORIZATION BEFORE OBTAINING BUILDING PERMIT OR OTHER CONSTRUCTION PERMITS AND BEFORE A WASTEWATER SYSTEM IS INSTALLED. *THIS IMPROVEMENT PERMIT IS SUBJECT TO REVOCATION IF THE INTENDED USE CHANGE FROM THOSE SHOWN ON THE IMPROVEMENT PERMIT. CHANGES SHALL REQUIRE HEALTH DEPARTMENT APPROVAL.
PROPERTY ADDRESS/LOCATION: Village Southland Mill Rd 60 Case Lane		TYPE OF WASTEWATER SYSTEM			
SUBDIVISION: Case Village		DESCRIPTION	INITIAL INSTALLATION	REPAIR	
LOT NUMBER: 30 1.16		DESIGN FLOW:	480		
REFERENCE SKETCH (SEE PLAT FOR DETAILS) Pond 		LTAR:	.3		
		ABSORPTION AREA:	1200²ft		
		TRENCH WIDTH:	3		
		TRENCH SPACING:	9'		
		TOTAL TRENCH LENGTH:	400'		
		NUMBER OF TRENCHES:	5016		
		GRAVEL DEPTH:	*18"		
		TANK SIZE:	1000		
		CONDITIONS:			
IMPROVEMENT PERMIT					DATE: 5-8-2K
FOR: ISSUED BY: Walter T. Vaughn RS					
OPERATION PERMIT					DATE: 5-12-01
SYSTEM INSTALLED BY: RICKY PEARCE ISSUED BY: Paul T. [Signature]					