

919-562-2127

PERMIT NUMBER 06841
Zoning # 16689GRANVILLE-VANCE DISTRICT HEALTH DEPARTMENT
IMPROVEMENT AND OPERATION PERMITS

COUNTY:	TAX NO.	TYPE OF ESTABLISHMENTS			*THIS PERMIT SHALL BE ACCOMPANIED BY A LAYOUT SHOWN ON A PLAT, INCLUDING SYSTEM REQUIREMENTS.
Granville	182500975971	RESIDENCE ☒	NUMBER OF BEDROOMS:	NUMBER OF OCCUPANTS:	
	SR. NO.	BUSINESS ☐	4	8 maximum	
OWNER:	MBC Homes	OTHER ☐	WATER SUPPLY	WELL ☒	
APPLICANT'S ADDRESS:		TYPE OF WASTEWATER SYSTEM	INITIAL INSTALLATION	REPAIR	*THIS IMPROVEMENT PERMIT IS SUBJECT TO REVOCATION IF THE INTENDED USES CHANGE FROM THOSE SHOWN ON THE IMPROVEMENT PERMIT. CHANGES SHALL REQUIRE HEALTH DEPARTMENT APPROVAL.
PO. Box 1011 Youngsville NC 27596		DESIGN FLOW:	1480 gpd	Type III g	
PROPERTY ADDRESS/LOCATION:		LTAR:	25 gpd/ft ²		
SUBDIVISION:		ABSORPTION AREA:	1920 ft ²		
LOT NUMBER:		TRENCH WIDTH:	3'		
REFERENCE SKETCH (SEE PLAT FOR DETAILS)		TRENCH DEPTH:	24"		
- Dig lines level and on contour; - Call 693-2688 for site meeting prior to installation - leave room for repair		TRENCH SPACING:	9' O.C.		
		TOTAL TRENCH LENGTH:	480'		
		NUMBER OF TRENCHES:	4		
		GRAVEL DEPTH:	Accepted status		PERMIT VALID FOR: 5 YEARS YES ☒ NO ☐
		TANK SIZE:	1200 gal		
		PUMP TANK SIZE:	N/A		NO EXPIRATION YES ☐ NO ☒
		DISTRIBUTION DEVICE:	Distribution Box		

IMPROVEMENT PERMIT DATE: 4-26-2010FOR: MBC Homes
ISSUED BY: David CumberCONSTRUCTION AUTHORIZATION FOR IMPROVEMENT PERMIT# 6841Unless otherwise indicated, the same conditions above apply regarding system type, layout, location and installation requirements.
(The wastewater system cannot be installed until authorization is signed)

Comments: Do not install in wet conditions

Date: 4-26-10 Environmental Health Specialist: David Cumber

Construction Authorization Addendum ☐ Yes ☒ No*****
OPERATION PERMIT

DATE: 8-18-10

SYSTEM INSTALLED BY: Triangle Pump & Tank

ISSUED BY: C.C. 8-17-10 David Cumber 8-18-10

PERFORMANCE, MONITORING, MAINTENANCE AND OPERATION
AS REQUIRED BY RULE .1961

Granville – Vance District Health Department
Environmental Health

Pin 18 25 00975 971

Permit Number 6841

☒ Improvement Permit

☒ Construction Authorization

Final Sketch

MBC
Applicants Name

Ironwood - lot 83
Subdivision – Section – Lot

Physical Address: Creedview

Bla Triangle
System Installer

8-17-10 / 8-18-10
Date

System design and details as installed.

Septic Tank Information:

Date: 6-29-10

Manufacture: Mills-1200

ID #: SIB-857

Pump Tank Information:

Date: /

Manufacturer: /

ID #: /

Distribution Box ☒


Pressure Manifold /

Serial Distribution /

Type of Facility: Residence

Number of Bedrooms: 4

Type of System: Infiltrator - Quick 4

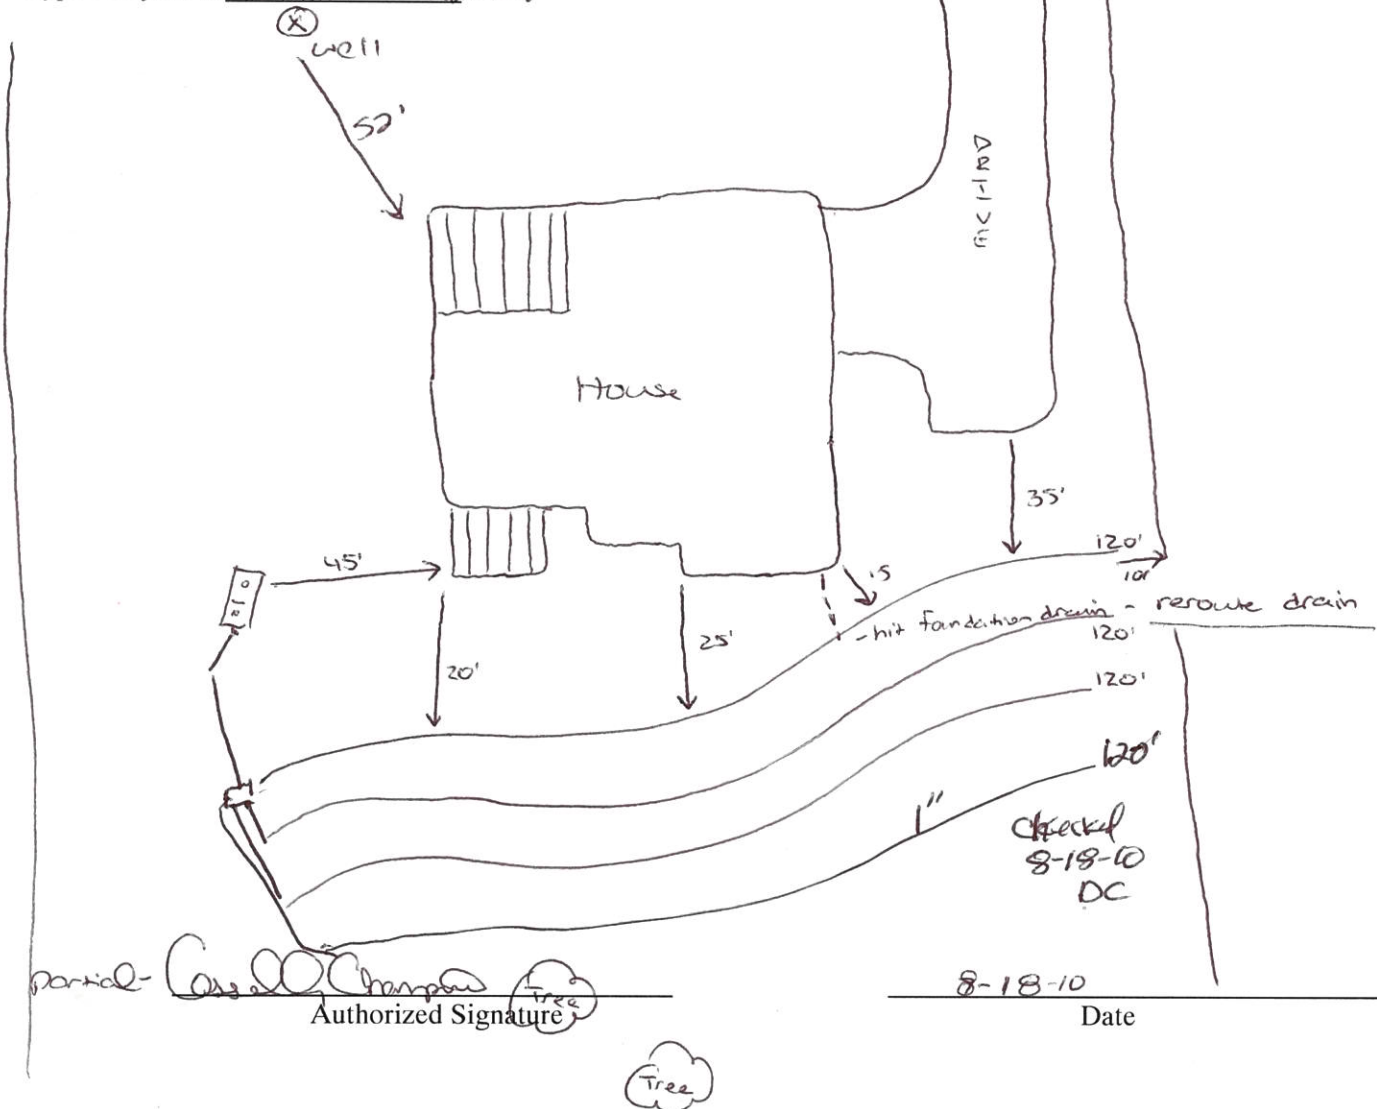

919-562-2127

Granville - Vance District Health Department
Environmental Health
Well Construction Permit

00250

Owner/Applicant: MBC Homes Date: 4-26-10
Address or Location of Property: Creekview Dr


Subdivision & Lot #: Tranwood 83 Septic Permit #: 6841
Zoning Permit #: 16689 Environmental Health Specialist: David Cumber

This well permit is to locate and site the area that a private groundwater well may be established on the property listed above by the Environmental Health Specialists of Granville County. If one does not locate the well in the approved area and complete the well as specified by the 15A NCAC .02C rules, then permits may be revoked. At completion of drilling of the well, grout must be witnessed by EHS and a well log turned into Environmental Health.

Minimum Setbacks: (these are the main setbacks, but not all required setbacks)

Setback from property lines – 10 ft Setback from septic tank and drain field, including repair area – 100 ft
Setback from structural foundations – 25 ft Setback from ponds, lakes or other bodies of water – 50 ft

Site Sketch:

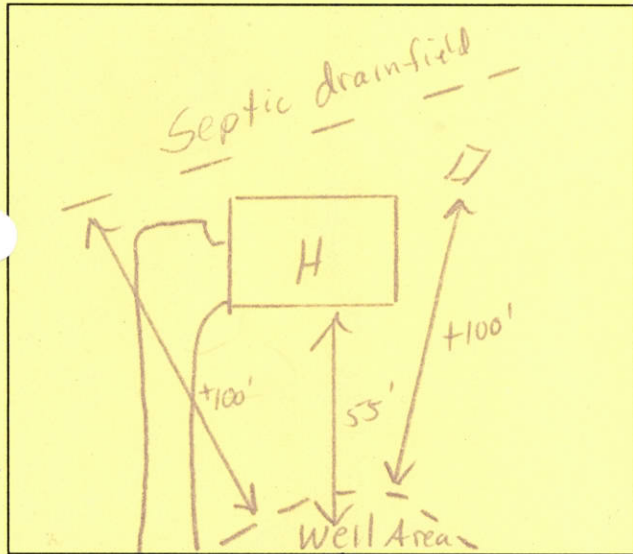


Conditions: Call 693-2688 w/question

Authorized Agent: David Cumber
Date: 4-26-10

Well Grout: (Circle or write in)

Witnessed: Yes or No EHS Agent: Chapin
Date: 5-27-10 Annular Space Open: Yes or No
Over reamed: Yes or No
Method: Pump ☒ Poured ☐ Pressure
Depth Grouted: 20 ft+
Well Log received: Yes or No (EHS to Attach to Permit)

As Built Drawing:

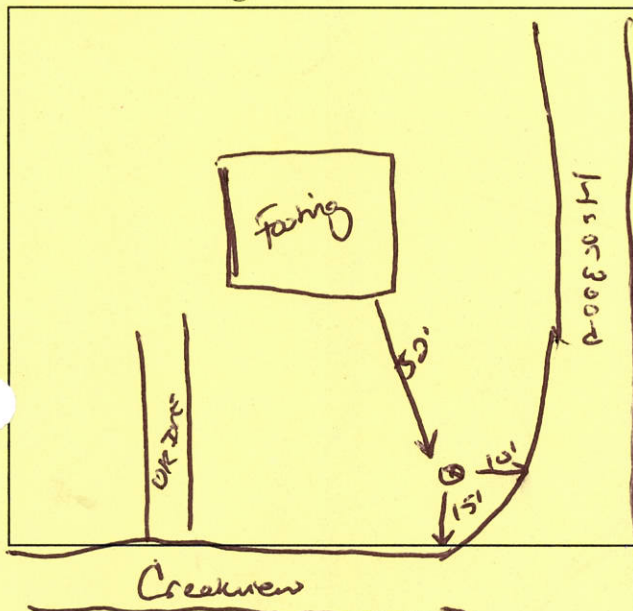

Well Final: (Place a check mark when finalized)

Seal Present and Intact: ☒ Air Vent: ☒
Hose Spigot: ☒ Electrical Box: ☒
Pump Installer Tag: ☒ Well Installer Tag: ☒
All holes sealed: ☒ 12" above grade: ☒

Comments: _____

Well Completion Permit: SKnoth, EHS
Date Completed: 9/21/10

Water Samples Taken: Date: 9/21/10
EHS: SK **Results:** _____
Retest: _____ **Results:** _____