

Granville - Vance District Health Department Environmental Health

Pin 182500216282Permit Number 6925☒ Improvement Permit☒ Construction Authorization

Final Sketch

Pinnacle Homes

Applicants Name

Perseus at Smith Creek - lot 80

Subdivision - Section Lot

Physical Address: Old Still WayTruework Inc

System Installer

7-7-09

Date

System design and details as installed.

Septic Tank Information:

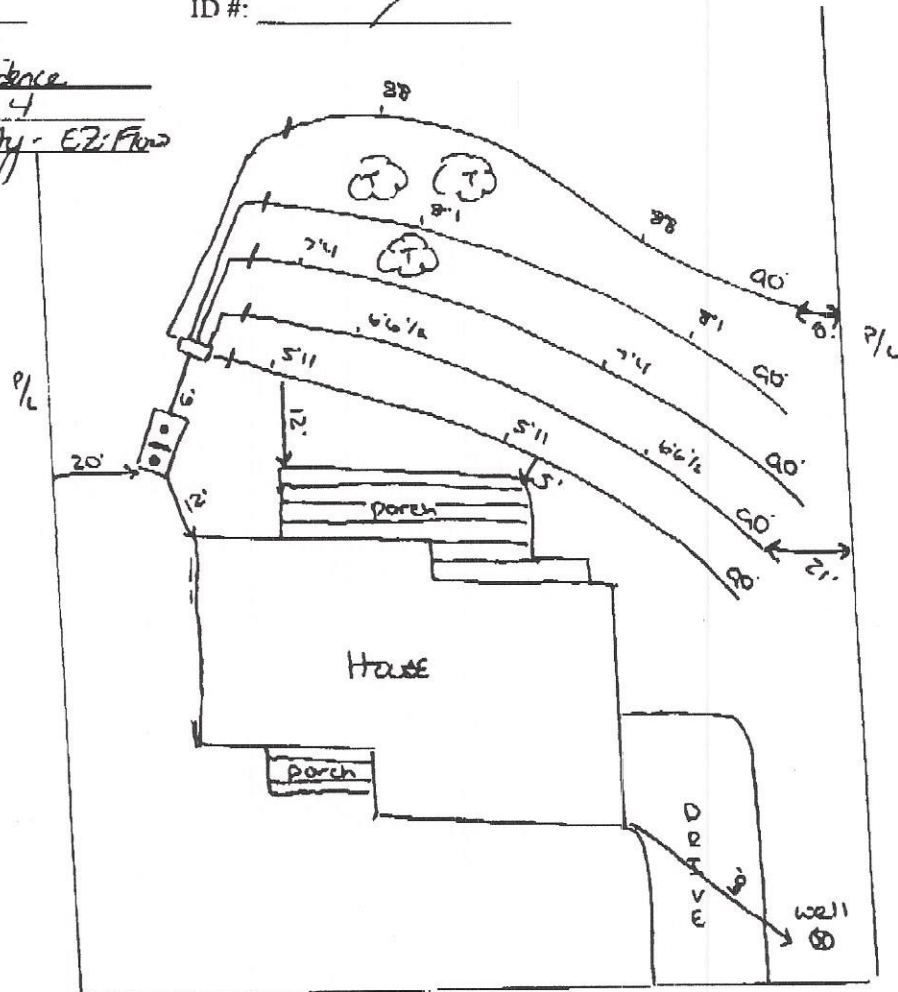
Date: 8-3-07
 Manufacture: DB 88734
 ID #: 1200

Pump Tank Information:

Date:
 Manufacture:
 ID #:

Distribution Box

☒ Pressure Manifold
☐ Serial Distribution

Type of Facility: ResidenceNumber of Bedrooms: 4Type of System: gravity - EZ-Flow

Cassidy [Signature]
 Authorized Signature

7-7-09

Date