

WELL CONSTRUCTION RECORD

North Carolina - Department of Environment and Natural Resources - Division of Water Quality - Groundwater Section

WELL CONTRACTOR (INDIVIDUAL) NAME (print) WILBERT JONES CERTIFICATION # 2309

WELL CONTRACTOR COMPANY NAME RANKIN WILLIAMSON, INC. PHONE # ()

STATE WELL CONSTRUCTION PERMIT# _____ ASSOCIATED WQ PERMIT# _____
(if applicable) (if applicable)

1. WELL USE (Check Applicable Box): Residential ☐ Municipal/Public ☐ Industrial ☐ Agricultural ☐
Monitoring ☐ Recovery ☐ Heat Pump Water Injection ☐ Other ☐ If Other, List Use _____

2. WELL LOCATION:
Nearest Town: OXFORD County GRAVILE
UZZLE RD
(Street Name, Numbers, Community, Subdivision, Lot No., Zip Code)

Topographic/Land setting
☐ Ridge ☐ Slope ☐ Valley ☐ Flat
(check appropriate box)
Latitude/longitude of well location _____
(degrees/minutes/seconds)

3. OWNER: TODD MCDONALD
Address 7613 HUNTER RD
BARNES, NC. 27503
(Street or Route No.)
City or Town State Zip Code
()- ()- ()

Latitude/longitude source: ☐ GPS ☐ Topographic map
(check box)

4. DATE DRILLED 7-22-11
5. TOTAL DEPTH: 300

DEPTH DRILLING LOG
From To Formation Description
0-8 BRN clay
8-300 ROCK

6. DOES WELL REPLACE EXISTING WELL? YES ☐ NO ☒

7. STATIC WATER LEVEL Below Top of Casing: 30 FT.
(Use "+" if Above Top of Casing)

PERMIT # 513

8. TOP OF CASING IS 1 FT. Above Land Surface*
*Top of casing terminated at/or below land surface requires a variance in accordance with 15A NCAC 2C .0118.

9. YIELD (gpm): 5 METHOD OF TEST AIR

10. WATER ZONES (depth): HYDRO-FRACK

11. DISINFECTION: Type HTH Amount 1LB


LOCATION SKETCH
Show direction and distance in miles from at least two State Roads or County Roads. Include the road numbers and common road names.

12. CASING: Wall Thickness
From 0 To 24 Ft. Diameter 6 7/8 Weight/Ft. 250 Material PVC

13. GROUT: Depth 0 To 20 Ft. Material CONCRETE Method POUR

14. SCREEN: Depth From To Ft. Diameter in. Slot Size in. Material

15. SAND/GRAVEL PACK: Depth From To Ft. Size Material

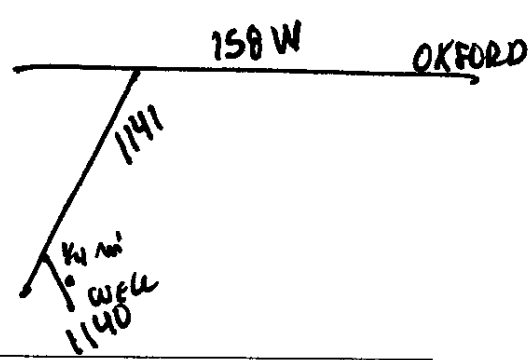

16. REMARKS: _____

I DO HEREBY CERTIFY THAT THIS WELL WAS CONSTRUCTED IN ACCORDANCE WITH 15A NCAC 2C, WELL CONSTRUCTION STANDARDS, AND THAT A COPY OF THIS RECORD HAS BEEN PROVIDED TO THE WELL OWNER

Wilbert Jones

SIGNATURE OF PERSON CONSTRUCTING THE WELL DATE

Submit the original to the Division of Water Quality, Groundwater Section, 1636 Mail Service Center - Raleigh, NC 27699-1636 Phone No. (919) 733-3221, within 30 days. GW-1 REV. 07/2001

invoice

RANKIN WILLIAMSON, INC.
P.O. Box 647
BUFFALO JUNCTION, VIRGINIA 24529

Date: 7/22/11
Due Date:

Inv. No.:
Page No.:

TODD McDONALD
7613 HUMPHREY KNOLL RD.
BAHAMA, N.C. 27503

SHIP VIA	FOB	TERMS	YOUR #	OUR #	SALES REP
PERMIT # 513		919-461-8634			
DESCRIPTION		ORDERED	ITEM SHIPPED	UNIT PRICE	EXTENDED PRICE
REFERENCE		UNIT MEASURE	BACK ORDERED	ITEM DISCOUNT	
300' @\$8.50 PER FOOT				\$	2,550.00
24' PVC CASING @\$5.00 PER FOOT				\$	120.00
CEMENT GROUT				\$	450.00
1-6 1/4 x 1 SEAL, DECO ROCK, PUMP SCREEN				\$	236.00
TAX				\$	11.80
HYDRO-FRACK WELL				\$	1,000.00
FUEL S.C.				\$	125.00
5 GPM					
CHLORINE HAS BEEN ADDED TO WELL AND SHOULD BE PUMPED OFF BEFORE USE.					
Thank You For Your Business				SUB TOTAL	
2% Service Charge On All Accounts Over 30 days. Annual Interest Rate Of 24%				TAX	
				TOTAL	\$ 4,492.80
				NET TO PAY	