

GRANVILLE-VANCE HEALTH DEPARTMENT—Sewage Disposal Record

Owner or Contractor Floyd Vaughan Date 5-4-06 S.R. No. 1131

Location/Address 3257 Trump Wilkins Rd.

Subdivision/Mobile Home Park Name _____ Lot Size 1 acm

Permit No. # 0584 Lot No. _____

New System _____ Repair ☒

House ☒ Mobile Home _____ Business _____

No. Bedrooms 3 No. People _____ No. Toilets _____

Water Supply: Private Eft. Approved _____

Semi-Public _____ Unapproved _____

Public _____ None _____

Nitrification System:

Tank Size 1000 gal.

Distribution Box NO No. Lines 1

Nitrification Field 900 Sq. Ft.

Lines: 1 2 3 4 5 6


Width 3

Length 300'

Grade 14" Total

Stone Depth E-Z-Flow

Layout to be followed by installer:

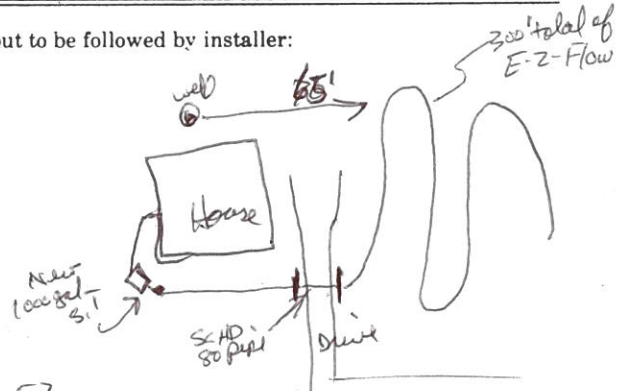

Improvements Permit By Jimmy B. Clapp Installer Seamus O'Brien

Certificate of Completion By Jimmy B. Clapp Date of Inspection 5-4-06

* Construction must comply with all other applicable state and local regulations, but the permit is not a guarantee that the system will not malfunction and the Granville-Vance Health District will not be held responsible for a malfunctioning system.

3:00 for ad 0'Brien
5-4-06
PERMIT NUMBER 05846

GRANVILLE-VANCE DISTRICT HEALTH DEPARTMENT IMPROVEMENT AND OPERATION PERMITS

COUNTY:	TAX NO.	TYPE OF ESTABLISHMENTS			*THIS PERMIT SHALL BE ACCOMPANIED BY A LAYOUT SHOWN ON A PLAT, INCLUDING SYSTEM REQUIREMENTS.
<u>Granville</u>	SR. NO. <u>1131</u>	RESIDENCE ☒ BUSINESS ☐ OTHER ☐	NUMBER OF BEDROOMS: <u>3</u>	NUMBER OF OCCUPANTS: <u>4</u>	
OWNER: <u>Floyd Vaughan</u>		WATER SUPPLY	WELL ☒ PUBLIC ☐	OTHER ☐	
APPLICANT'S ADDRESS: <u>3257 Trump Wilkins Rd. Stem NC 27851</u>		TYPE OF WASTEWATER SYSTEM	INITIAL INSTALLATION ☒	REPAIR ☐	
PROPERTY ADDRESS/LOCATION: <u>Same</u>		DESIGN FLOW: <u>360GD</u>			*THIS IMPROVEMENT PERMIT IS SUBJECT TO REVOCATION IF THE INTENDED USES CHANGE FROM THOSE SHOWN ON THE IMPROVEMENT PERMIT. CHANGES SHALL REQUIRE HEALTH DEPARTMENT APPROVAL.
SUBDIVISION:		LTAR: <u>.36F²</u>			
LOT NUMBER:		ABSORPTION AREA: <u>900F²</u>			
REFERENCE SKETCH (SEE PLAT FOR DETAILS)		TRENCH WIDTH: <u>3'</u>			
		TRENCH DEPTH: <u>18-24"</u>			PERMIT VALID FOR 5 YEARS YES ☒ NO ☐ NO EXPIRATION YES ☐ NO ☒
		TRENCH SPACING: <u>9'</u>			
		TOTAL TRENCH LENGTH: <u>300'</u>			
		NUMBER OF TRENCHES: <u>1</u>			
		GRAVEL DEPTH: <u>Innovative</u>			
		TANK SIZE: <u>1600 gal</u>			
	PUMP TANK SIZE: <u>-</u>				
		DISTRIBUTION DEVICE: <u>Serial Dist</u>			

IMPROVEMENT PERMIT DATE: 5-3-06

FOR: Floyd Vaughan
ISSUED BY: Jimmy B Clayton

CONSTRUCTION AUTHORIZATION FOR IMPROVEMENT PERMIT# 5846

Unless otherwise indicated, the same conditions above apply regarding system type, layout, location and installation requirements.
(The wastewater system cannot be installed until authorization is signed)

Comments: Keep tanks & system at least 50' from Endy well

Date: 5-3-06 Environmental Health Specialist: Jimmy B Clayton

Construction Authorization Addendum ☐ Yes ☒ No

OPERATION PERMIT

DATE: 5-4-06

SYSTEM INSTALLED BY: Seamus D. Brinton

ISSUED BY: Jimmy B Clayton

PERFORMANCE, MONITORING, MAINTENANCE AND OPERATION
AS REQUIRED BY RULE .1961