

GRANVILLE-VANCE HEALTH DEPARTMENT—Sewage Disposal Record

Owner or Contractor Wynn Const. Co Date 1-15-08 S.R. No. 1629
 Location/Address Brookdale Dr
 Subdivision/Mobile Home Park Name Brookdale Lot Size _____
 Permit No. # 6094 Lot No. 21

New System ☒ Repair _____
 House ☒ Mobile Home _____ Business _____
 No. Bedrooms 4 No. People _____ No. Toilets _____
 Water Supply: Private ☒ Approved _____
 Semi-Public _____ Unapproved _____
 Public _____ None _____

Nitrification System:

Tank Size 1000 gal.
 Distribution Box ☒ No. Lines 4
 Nitrification Field 1200 Sq. Ft.
 Lines:


1	2	3	4	5	6	
Width	<u>3'</u>	<u>3'</u>	<u>3'</u>	<u>3'</u>		
Length	<u>100'</u>	<u>100'</u>	<u>100'</u>	<u>102'</u>		
Grade	<u>0"</u>	<u>0"</u>	<u>0"</u>	<u>0"</u>		
Stone Depth	<u>E-2-Flow</u>					

Layout to be followed by installer:

Improvements Permit By DAVID Cumbee, RS Installer Robert Blackley
 Certificate of Completion By 1-15-08 Date of Inspection Jimmy B. Clayton, RS

* Construction must comply with all other applicable state and local regulations, but the permit is not a guarantee that the system will not malfunction and the Granville-Vance Health District will not be held responsible for a malfunctioning system.

NOTE: Make sketch of installation showing location of house, septic tanks, privies, water supplies on adjacent property, etc. Write in measurements in order that installations may be located at later date.

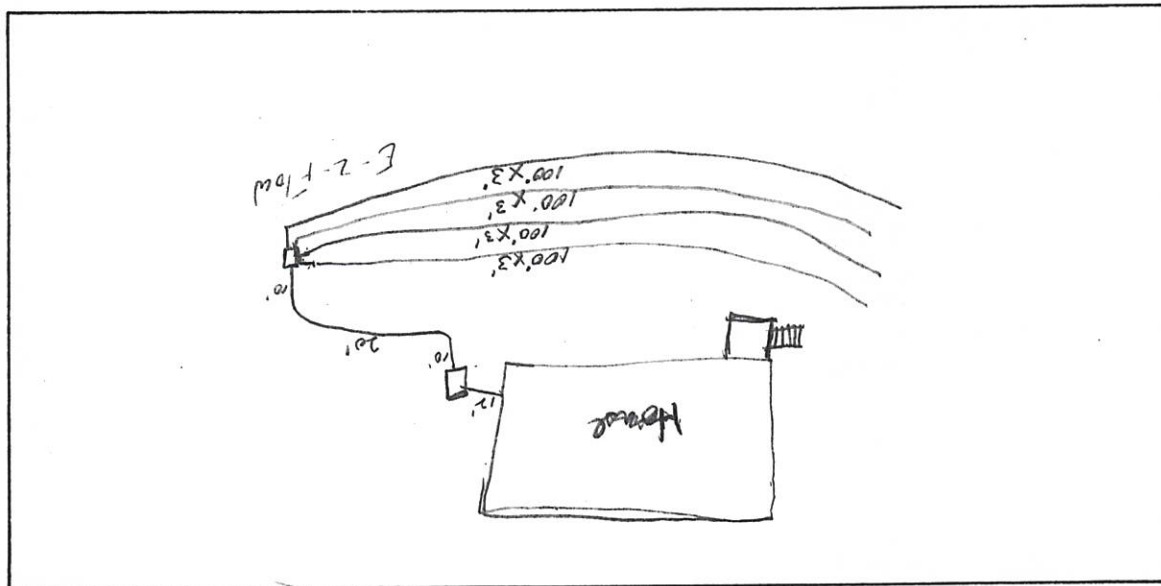

Brookdale Dr.