

PERMIT NUMBER 07242

GRANVILLE-VANCE DISTRICT HEALTH DEPARTMENT IMPROVEMENT AND OPERATION PERMITS

Zoning #
17426

COUNTY:	TAX NO.	TYPE OF ESTABLISHMENTS			*THIS PERMIT SHALL BE ACCOMPANIED BY A LAYOUT SHOWN ON A PLAT, INCLUDING SYSTEM REQUIREMENTS.		
<i>Granville</i>	SR. NO.	RESIDENCE ☒ BUSINESS ☐ OTHER ☐	NUMBER OF BEDROOMS: <i>4</i>	NUMBER OF OCCUPANTS:			
	OWNER: <i>Cheryle Stallings</i>	WATER SUPPLY	WELL ☒ PUBLIC ☐	OTHER ☐			
APPLICANT'S ADDRESS: <i>Ducatte Building Co. 9008 Coolbreeze Ct. Wake Forest 27587</i>		TYPE OF WASTEWATER SYSTEM	INITIAL INSTALLATION <i>Type IIa</i>	REPAIR <i>Type IIa</i>	*THIS IMPROVEMENT PERMIT IS SUBJECT TO REVOCATION IF THE INTENDED USES CHANGE FROM THOSE SHOWN ON THE IMPROVEMENT PERMIT. CHANGES SHALL REQUIRE HEALTH DEPARTMENT APPROVAL.		
PROPERTY ADDRESS/LOCATION: <i>3600 Trappers Run</i>		DESIGN FLOW:	<i>480 gpd</i>				
SUBDIVISION: <i>N/A</i>		LTAR:	<i>.3 gpd/ft²</i>				
LOT NUMBER:		ABSORPTION AREA:	<i>1600 ft²</i>				
REFERENCE SKETCH (SEE PLAT FOR DETAILS)		TRENCH WIDTH:	<i>3'</i>				
<i>Stub out plumbing and set tank to allow for +100' drain-lines, on contour, and keeping 10' set-back from property line</i> <i>trench depth 30"</i>		TRENCH DEPTH:	<i>30"</i>		PERMIT VALID FOR: 5 YEARS YES ☒ NO ☐		
		TRENCH SPACING:	<i>9' O.C.</i>				
		TOTAL TRENCH LENGTH:	<i>533' / 400'</i>				
				NUMBER OF TRENCHES:	<i>4 or 5</i>		NO EXPIRATION YES ☐ NO ☒
				GRAVEL DEPTH:	<i>12" / accepted</i>		
				TANK SIZE:	<i>1200 gal</i>		
				PUMP TANK SIZE:			
		DISTRIBUTION DEVICE:	<i>Distribution Box</i>				

IMPROVEMENT PERMIT

DATE:

4-20-2012

FOR:

ISSUED BY:

CONSTRUCTION AUTHORIZATION FOR IMPROVEMENT PERMIT# 7242

Unless otherwise indicated, the same conditions above apply regarding system type, layout, location and installation requirements.

(The wastewater system cannot be installed until authorization is signed)

Comments:

Do not install in wet conditions - Call 693-2688 if questions

Date:

4-20-2012

Environmental Health Specialist:

David Cumber

Construction Authorization Addendum

☐ Yes ☒ No

OPERATION PERMIT

DATE:

9-24-2012

SYSTEM INSTALLED BY:

ISSUED BY:

Mark Young
David Cumber

PERFORMANCE, MONITORING, MAINTENANCE AND OPERATION
AS REQUIRED BY RULE .1961

Granville - Vance District Health Department

00724

Environmental Health

Well Construction Permit


Owner/Applicant: Cherie Stallings Date: 4-20-2012
 Address or Location of Property: 3600 Trappers Run

Subdivision & Lot #: _____ Septic Permit #: 7242
 Zoning Permit #: 17426 Environmental Health Specialist: David Cumber

This well permit is to locate and site the area that a private groundwater well may be established on the property listed above by the Environmental Health Specialists of Granville County. If one does not locate the well in the approved area and complete the well as specified by the 15A NCAC .02C rules, then permits may be revoked. At completion of drilling of the well, grout must be witnessed by EHS and a well log turned into Environmental Health.

Minimum Setbacks: (these are the main setbacks, but not all required setbacks)

Setback from property lines – 10 ft Setback from septic tank and drain field, including repair area – 100 ft
 Setback from structural foundations – 25 ft Setback from ponds, lakes or other bodies of water – 50 ft

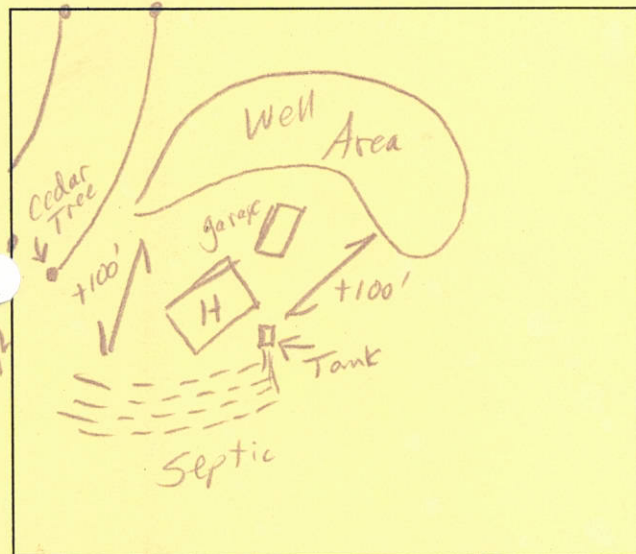
Site Sketch:

Conditions: Call 693-2688
w/ questions

Authorized Agent: David Cumber
Date: 4-20-2012

1 Well Grout: (Circle or write in)

Witnessed: Yes or No EHS Agent: David Cumber
 Date: 10-15-12 Annular Space Open: Yes or No
 Over reamed: Yes or No Depth Grouted: 20
 Method: Pump X Poured Pressure
 Well Log received: Yes or No (EHS to Attach to Permit)
 Driller Name: Darwood Davis Cert. # 2385
 Depth: 405' Casing Depth: 56 GPM: 50

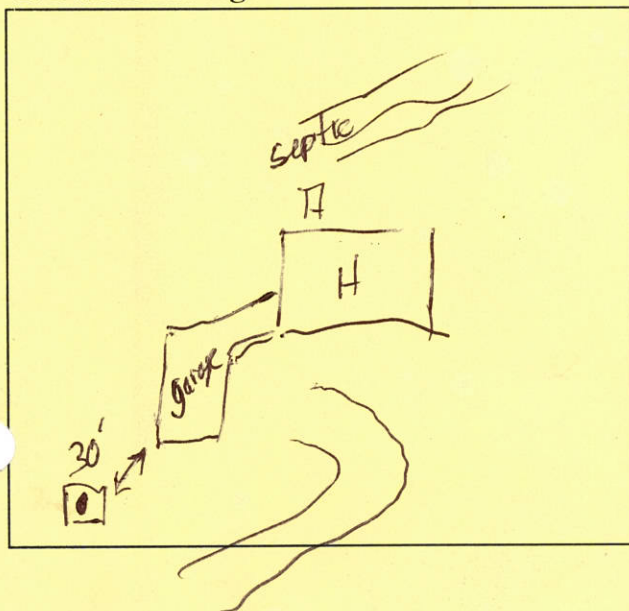As Built Drawing:**# 2 Well Final: (Place a check mark when finalized)**

Seal Present and Intact: Air Vent:
 Hose Spigot: Electrical Box:
 Pump Installer Tag: Well Installer Tag:
 All holes sealed: 12" above grade:

Comments:
Pump installer 2386
depth 200'
10-3-12

3 Well Completion Permit: DC EHS
Date Completed: 1-15-13



4 Water Samples Taken: Date: 1-7-13
 EHS: DC Results: Present - Coliform
 Retest: Results:

CHERYL POOLE STALLINGS

BRASSFIELD TOWNSHIP
GRANVILLE COUNTY, NORTH CAROLINA

SCALE 1"=100' MARCH 10, 2012

PLAT FILE# 12-G-023

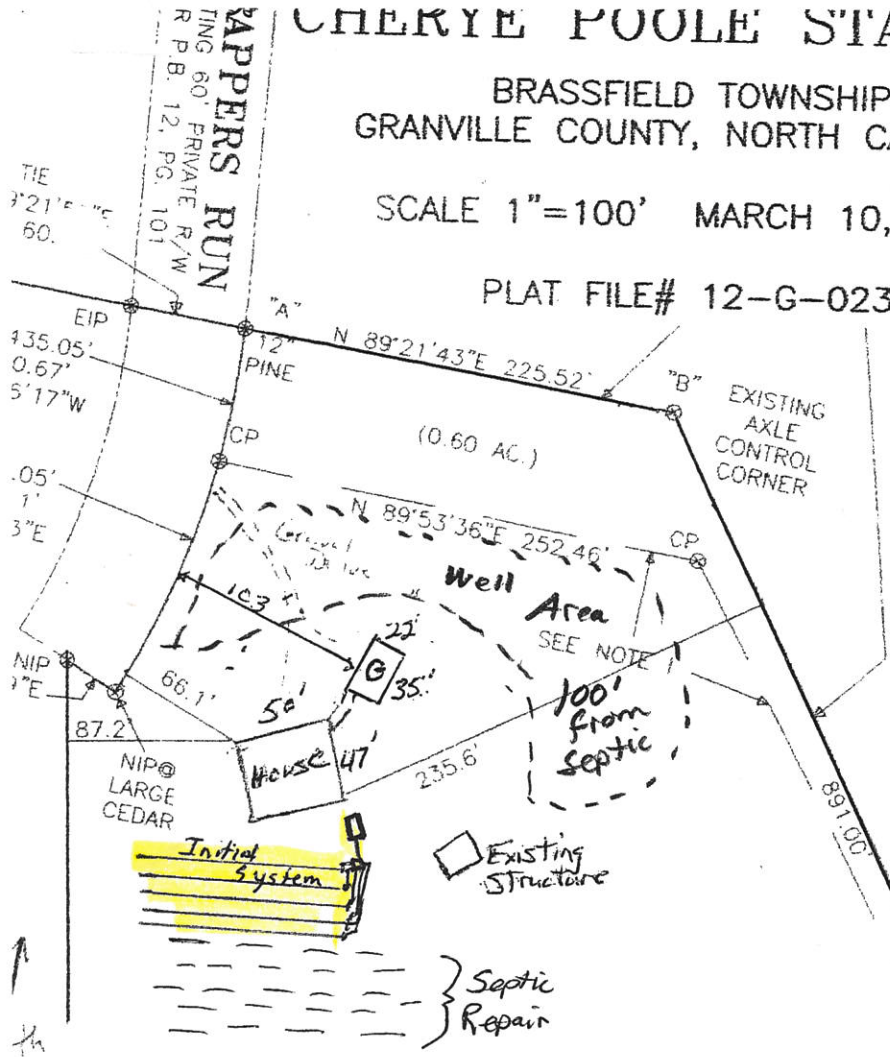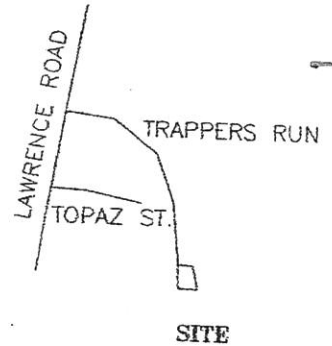

REFERENCES
D.B.574, PG. 150
P.B.12, PG. 101

NOTICE TO APPLICANT AND HEALTH/INSPECTION DEPTS.
Any changes made to this drawing/ plat or to the physical siting of the structure or use herein permitted without written approval from the Granville County Planning Department shall render this Zoning Ordinance void and subject to legal action per Section VIII-2, VIII-4 of the Granville County Zoning Ordinance.

LEGEND / SYMBOLS

EIP	EXISTING IRON PIPE OR ROD
NIP	NEW IRON PIPE OR PIN
EPK	EXISTING PK NAIL
NPK	NEW PK NAIL
ECPS	EXISTING COTTON SPINDLE SPIKE
NCPS	NEW COTTON SPINDLE SPIKE
ERRS	EXISTING RAILROAD SPIKE
NRRS	NEW RAILROAD SPIKE
ECM	EXISTING CONCRETE MONUMENT
NCM	NEW CONCRETE MONUMENT
FO	FIBER OPTICS WITNESS POST
CP	COMPUTED POINT - NOTHING SET
TP	TELEPHONE PEDESTAL
PB	POWER BOX
R/W	RIGHT OF WAY

5 79.50 47.11 712 20'