

GRANVILLE-VANCE HEALTH DISTRICT

(Septic Tank) Improvements Permit & Certificate of Completion

Owner or Contractor Wiley A. Ashley Date 5-4-90 S.R. No. 1711
 Location/Address _____
 Subdivision/Mobile Home Park Name A+R Lot Size 3.0173
 Lot No. 6C

New System M/H Repair _____
 Residence M/H Other _____
 No. Bedrooms 3 No. People 3 No. Toilets 2
 Water Supply: Private ✓ Approved ✓
 Semi-Public _____ Unapproved _____
 Public _____ None _____

Nitrification System:

Tank Size 900 gal.
 Distribution Box ✓ No. Lines 3
 Nitrification Field 300-900 Sq. Ft.
 Lines:

	1	2	3	4	5	6
Width	<u>36</u>	<u>36</u>	<u>36</u>	<u>36</u>	<u>36</u>	<u>36</u>
Length	<u>18</u>	<u>29</u>	<u>100</u>	<u>20</u>	<u>100</u>	<u>65</u>
Grade	<u>0</u>	<u>1/2</u>	<u>0</u>	<u>1</u>	<u>0</u>	<u>4</u>
Stone Depth	<u>12</u>	<u>12</u>	<u>12</u>	<u>12</u>	<u>12</u>	<u>12</u>

Layout to be followed by installer:

* Keep system to back of lot.

**PERMIT GOOD FOR
5 YEARS FROM
DATE OF ISSUE**

Improvements Permit By James C. Parrott Installer Joel Powell
 Certificate of Completion By James C. Parrott Date of Inspection 6-7-90


* Construction must comply with all other applicable state and local regulations, but the permit is not a guarantee that the system will not malfunction and the Granville-Vance Health District will not be held responsible for a malfunctioning system.

GRANVILLE VANCE HEALTH DISTRICT

(Septic Tank) Improvements Permit & Certificate of Completion

Owner or Contractor: Wiley A. Alley
 Location/Address: Mobile Home Park Name: A+R
 Subdivision: Lot No. 6C
 Lot Size: 2.0112
 Date of Inspection: 6-2-90

Layout to be followed by installer:

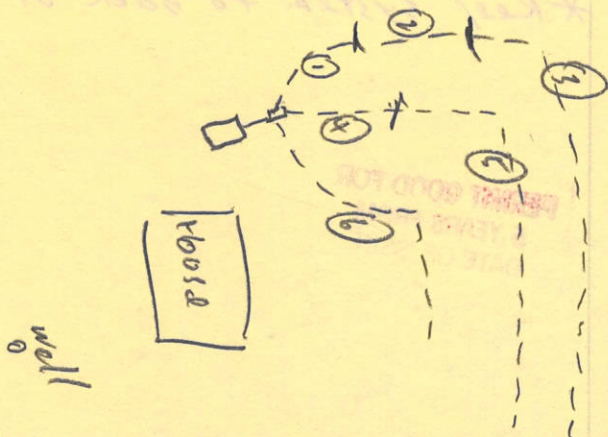

New System	Repair
Residence	Other
No. Bedrooms	No. Toilets
Water Supply: Private	Approved
Semi-Public	Unapproved
Public	None
Nitrification System:	
Tank Size	gal
Distribution Box	No. Lines
Nitrification Field	700' 200' Sp. Ft.
Lines:	
Width	1' 2' 3' 4' 5' 6'
Length	1' 2' 3' 4' 5' 6'
Grade	0' 1' 2' 3' 4'
Stone Depth	12' 14' 16' 18'

Improvements Permit By: Wiley A. Alley
 Certificate of Completion By: 11/4/95
 Date of Inspection: 6-2-90

* Construction must comply with all other applicable state and local regulations, but the permit is not a guarantee that the system will not malfunction and the Granville-Vance Health District will not be held responsible for a malfunctioning system.