

Shop
GRANVILLE-VANCE DISTRICT HEALTH DEPARTMENT
IMPROVEMENT AND OPERATION PERMITS

PERMIT NUMBER 1318

COUNTY:	TAX NO.	TYPE OF ESTABLISHMENTS			*THIS PERMIT SHALL BE ACCOMPANIED BY A LAYOUT SHOWN ON A PLAT, INCLUDING SYSTEM REQUIREMENTS. *THIS IMPROVEMENT PERMIT IS SUBJECT TO REVOCATION IF THE INTENDED USE CHANGES FROM THOSE SHOWN ON THE IMPROVEMENT PERMIT. CHANGES SHALL REQUIRE HEALTH DEPARTMENT APPROVAL.	
Granville	LOT SIZE	RESIDENCE _____	NUMBER OF BEDROOMS:	NUMBER OF OCCUPANTS:		
		BUSINESS _____	Z			
		OTHER _____				
APPLICANT'S NAME & ADDRESS Kelly Gentry		WATER SUPPLY WELL ☐ PUBLIC ☐	INITIAL INSTALLATION	REPAIR		
		TYPE OF WASTEWATER SYSTEM				
PROPERTY ADDRESS/LOCATION: 2910 Flat Rock Rd		DESIGN FLOW:	III g 240 gpd			
		LTAR:	0.3 gpd/sf ²			
SUBDIVISION:		ABSORPTION AREA:	600 sf ²			
		TRENCH WIDTH	36"			
LOT NUMBER:		TRENCH DEPTH:	24-28"			
		TRENCH SPACING:	9' o.c.			
REFERENCE SKETCH (SEE PLAT FOR DETAILS)		TOTAL TRENCH LENGTH:	200'			
		NUMBER OF TRENCHES:	2 or 3			
* Contractor may use a gravity system if minimum slope requirements can be met. * NEMA 4x control panel with alarm * 1/2" sch 40 taps with adjustment valves.		GRAVEL / ACCEPTED:	Accepted			PERMIT VALID FOR: 5 YEARS YES ☒ NO ☐
		TANK SIZE:	1000 gal			
		PUMP TANK SIZE:		N/A		NO EXPIRATION YES ☐ NO ☒
				DISTRIBUTION DEVICE:		

***** IMPROVEMENT PERMIT

DATE: 3-13-19

FOR: Kelly Gentry

ISSUED BY: Adam Cornett

CONSTRUCTION AUTHORIZATION FOR IMPROVEMENT PERMIT# 1318

Unless otherwise indicated, the same conditions above apply regarding system type, layout, location and installation requirement.

(The wastewater system cannot be installed until authorization is signed)

Comments: _____

Date: 3-13-19

Environmental Health Specialist: _____

Construction Authorization Addendum ☒ Yes ☐ No

OPERATION PERMIT

DATE: 6-2-19

SYSTEM INSTALLED BY: Blackley

ISSUED BY: [Signature]

PERFORMANCE, MONITORING, MAINTENANCE AND OPERATION

AS REQUIRED BY R.U.F. 1961

Granville – Vance District Health Department
Environmental Health

Pin 183700290333

Permit Number 7748

☒ Improvement Permit

☒ Construction Authorization

Final Sketch

Alma Blackley
Applicants Name

N/A
Subdivision – Section – Lot

Physical Address: 2916 Flat Rock Rd

Cole's Backhoe Service
System Installer

4-17-14
Date

System design and details as installed.

Septic Tank Information:

Date: 6-20-13

Manufacture: Ellis - 1000 gal

ID #: STB - 789

Pump Tank Information:

Date: _____

Manufacturer: _____

ID #: _____

Distribution Box ☒

Pressure Manifold _____

Serial Distribution _____


Pump Info: _____

Type of Facility: House

Number of Bedrooms: 2

Well Drilled: ☒

Type of System: ☒ Gravity _____ Pump ☒ Gravel _____ Polystyrene _____ Chamber _____ Other: _____

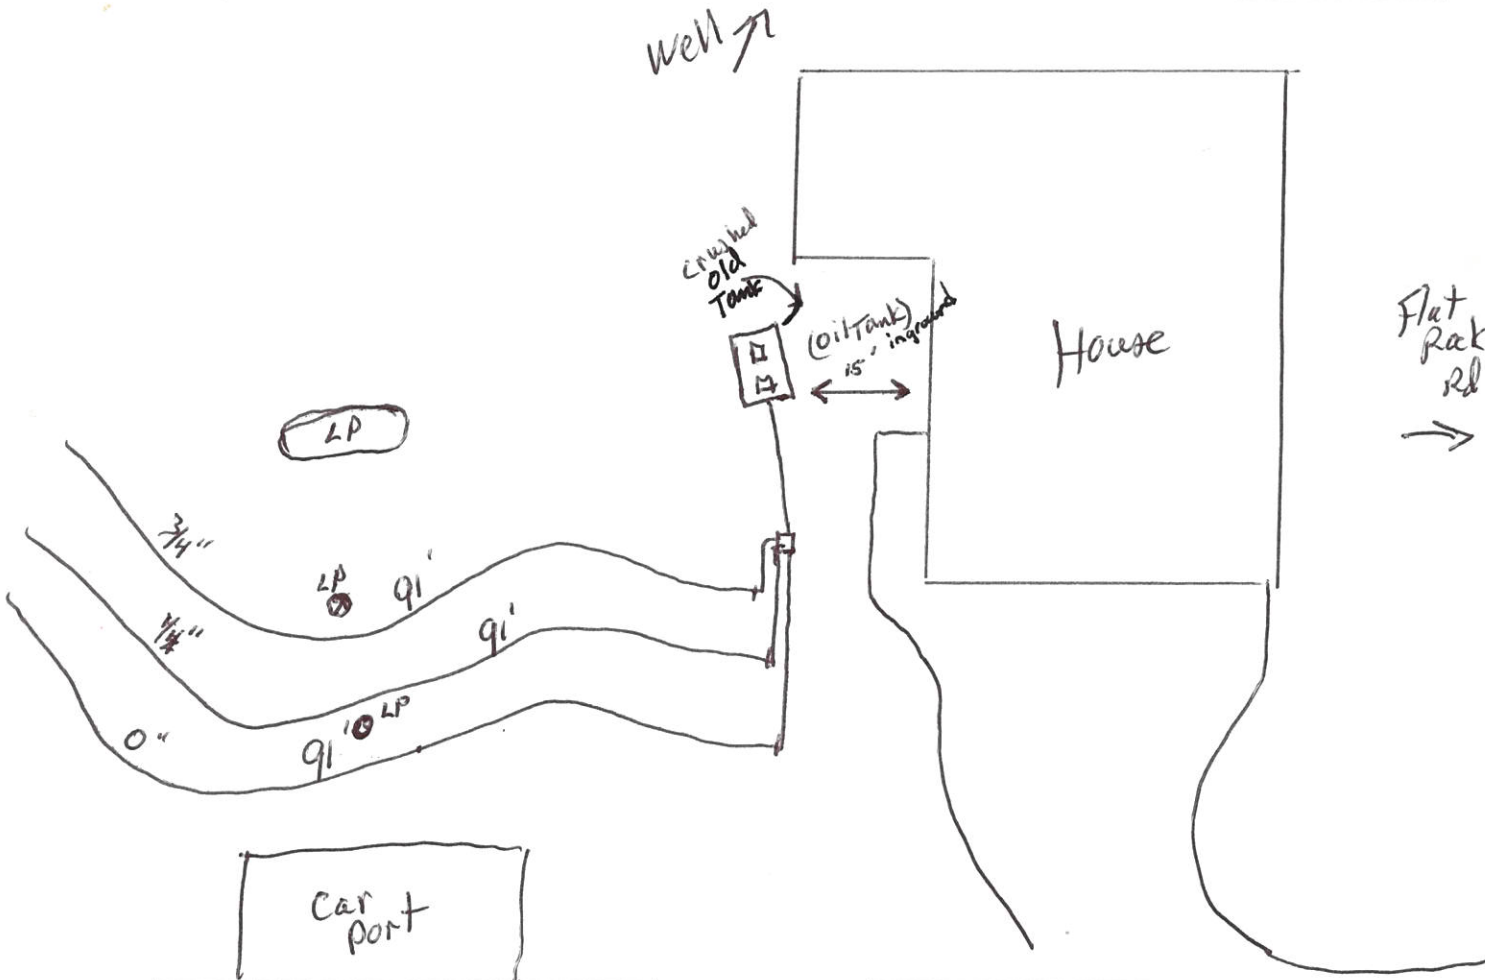

Authorized Signature

David Cole

Date

↓ Philo White Rd