

888

GRANVILLE-VANCE HEALTH DEPARTMENT—Sewage Disposal Record

Owner or Contractor Thomas Harris Date 7-23-97 S.R. No. 1159Location/Address Tral Carey Rd - SkmSubdivision/Mobile Home Park Name Deer Run Lot Size 3.2389±AcPermit No. # 888 Lot No. 20New System ☒ Repair ☐House ☐ Mobile Home ☒ Business ☐No. Bedrooms 3 No. People 6 No. Toilets 6Water Supply: Private ☒ Approved ☐Semi-Public ☐ Unapproved ☐Public ☐ None ☐

Nitrification System:

Tank Size 900 gal.Distribution Box ☒ No. Lines 4Nitrification Field 1200 Sq. Ft.Lines:

1	2	3	4	5	6
3'	3'	3'	3'		
94'	100'	104'	103'		
1 3/4"	1 1/2"	1 1/2"	1 1/2"		
12"	10"	12"	12"		

Width

Length

Grade


Stone Depth

Layout to be followed by installer:

Improvements Permit By M. E. Young Installer Blackley Bros.Certificate of Completion By Chris Hehl Date of Inspection 7-31-97

* Construction must comply with all other applicable state and local regulations, but the permit is not a guarantee that the system will not malfunction and the Granville-Vance Health District will not be held responsible for a malfunctioning system.

NOTE: Make sketch of installation showing location of house, septic tanks, privies, water supplies on adjacent property, etc. Write in measurements in order that installations may be located at later date.

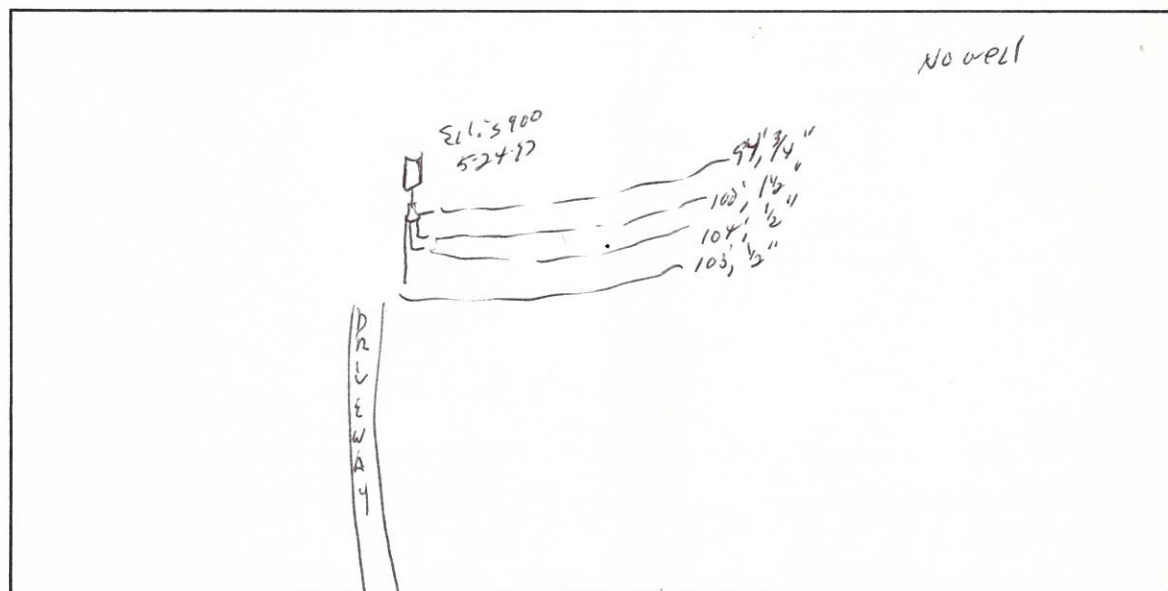

DEVELOPMENT RD