

GRANVILLE-VANCE HEALTH DEPARTMENT—Sewage Disposal Record

Owner or Contractor William Silverthorn Date 8-10-01 S.R. No. 1145
 Location/Address Locks Lane off Hobgood Rd.
 Subdivision/Mobile Home Park Name Cub Creek Lot Size 2.000 acres
 Permit No. # 3066 Lot No. 8

New System ☒ Repair _____
 House _____ Mobile Home ☒ Business _____
 No. Bedrooms 3 No. People 3 No. Toilets _____
 Water Supply: Private ☒ Approved _____
 Semi-Public _____ Unapproved _____
 Public _____ None _____

Nitrification System:


Tank Size 1000 gal.
 Distribution Box ☒ No. Lines 3
 Nitrification Field 1028 Sq. Ft.
 Lines: 1 2 3 4 5 6
 Width 3' 3' 3' _____ _____ _____
 Length 116' 117' 133' _____ _____ _____
 Grade 0' 0' 6' _____ _____ _____
 Stone Depth 12" 12" 12" _____ _____ _____

Layout to be followed by installer:

Improvements Permit By Jimmy Clayton Installer Paul Carrington
 Certificate of Completion By Eddie Yount Date of Inspection 8-10-01

* Construction must comply with all other applicable state and local regulations, but the permit is not a guarantee that the system will not malfunction and the Granville-Vance Health District will not be held responsible for a malfunctioning system.

NOTE: Make sketch of installation showing location of house, septic tanks, privies, water supplies on adjacent property, etc. Write in measurements in order that installations may be located at later date.

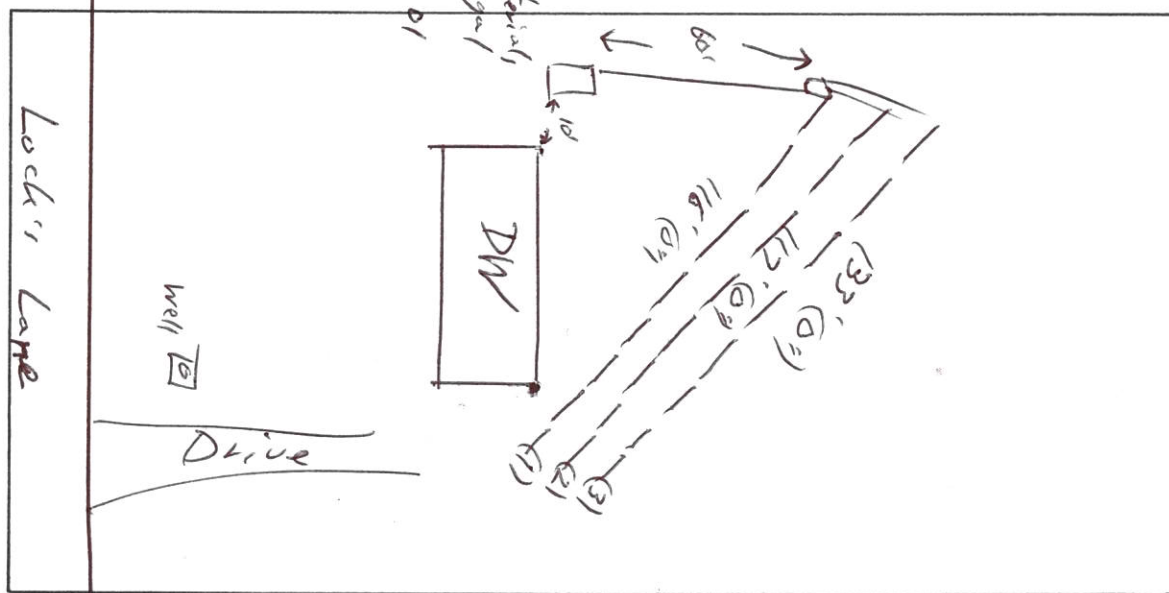

Hobgood Rd SR 1145