

1724

GRANVILLE-VANCE HEALTH DEPARTMENT—Sewage Disposal Record

Owner or Contractor Michael Lipman Date 4-28-97 S.R. No. 965
Location/Address Whitwinds Way 3644, Franklin
Subdivision/Mobile Home Park Name Whitfield Chase Lot Size _____
Permit No. # 724 Lot No. 49

New System _____ Repair ☒
House ☒ Mobile Home _____ Business _____
No. Bedrooms 5 No. People 7 No. Toilets _____
Water Supply: Private ☒ Approved _____
Semi-Public _____ Unapproved _____
Public _____ None _____

Nitrification System:


Tank Size 1000 gal.
Distribution Box ☒ No. Lines 2
Nitrification Field 920 Sq. Ft.
Lines: 1 2 3 4 5 6
Width 2 3 _____
Length 67' 1/4" 67' 1/4" _____
Grade 0" 10" 0" 1/4" _____
Stone Depth 18" 18" _____

Layout to be followed by installer:

Improvements Permit By Chris Hedrick Installer Blanchy Bros.
Certificate of Completion By Chris Hedrick Date of Inspection 6-8-97

* Construction must comply with all other applicable state and local regulations, but the permit is not a guarantee that the system will not malfunction and the Granville-Vance Health District will not be held responsible for a malfunctioning system.

NOTE: Make sketch of installation showing location of house, septic tanks, privies, water supplies on adjacent property, etc. Write in measurements in order that installations may be located at later date.

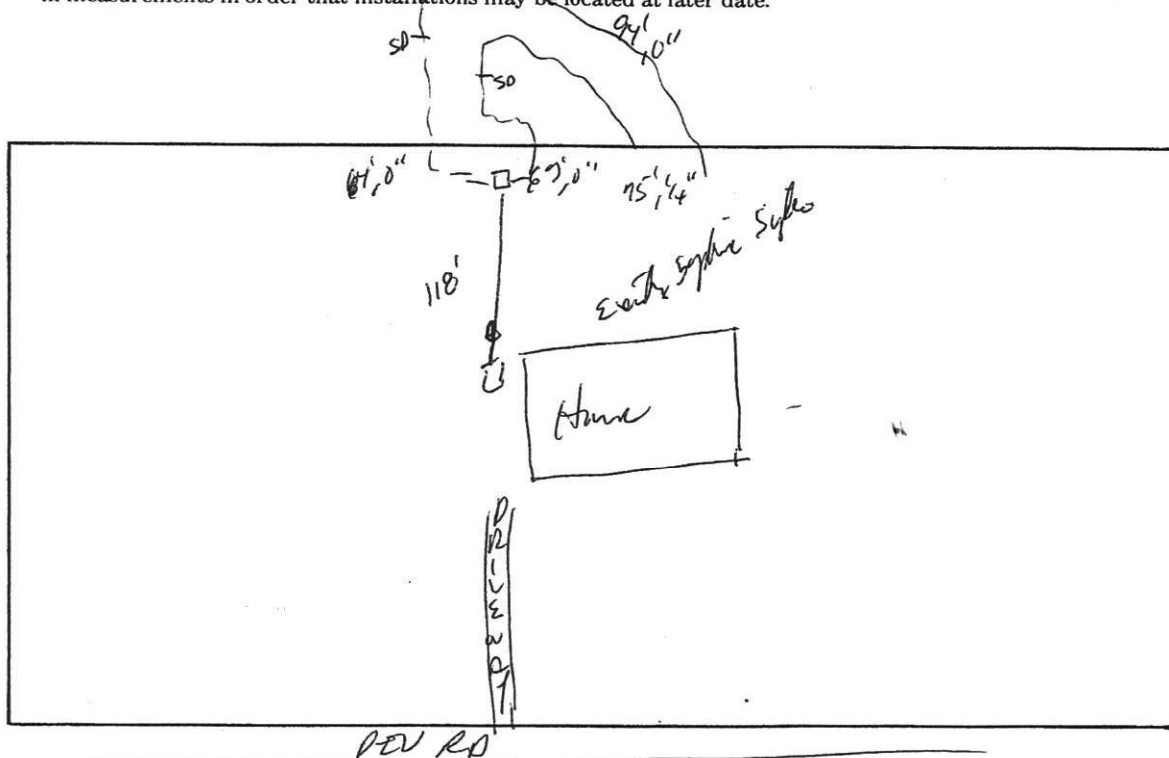

GRANVILLE-VANCE HEALTH DEPARTMENT—Sewage Disposal Record

Owner or Contractor Michael LeFinger Date 5-3-96 S.R. No. 18965
 Location/Address 3644 Whitwinds Way - Franklinton NC 27525
 Subdivision/Mobile Home Park Name Whitfield Chase Lot Size _____
 Permit No. # 120 Lot No. 49

New System ☒ Repair ☒
 House ☒ Mobile Home _____ Business _____
 No. Bedrooms 5 No. People 7 No. Toilets _____
 Water Supply: Private ☒ Approved _____
 Semi-Public _____ Unapproved _____
 Public _____ None _____

Nitrification System:

Tank Size 2000 gal.
 Distribution Box ☒ No. Lines 4
 Nitrification Field added Sq. Ft. _____
 Lines: 1 2 3 4 5 6
 Width 3' _____
 Length 22' _____
 Grade 1" _____
 Stone Depth 28" _____

Layout to be followed by installer:


* Addition of line necessary because of improper
 sizing of system.
 - Addition will accommodate amount of BR + People.

see # 120 Gary Shyly

Improvements Permit By Chris Hest Installer Blumley Bros.
 Certificate of Completion By Chris Hest Date of Inspection 5-6-96

* Construction must comply with all other applicable state and local regulations; but the permit is not a guarantee that the system will not malfunction and the Granville-Vance Health District will not be held responsible for a malfunctioning system.

NOTE: Make sketch of installation showing location of house, septic tanks, privies, water supplies on adjacent property, etc. Write in measurements in order that installations may be located at later date.

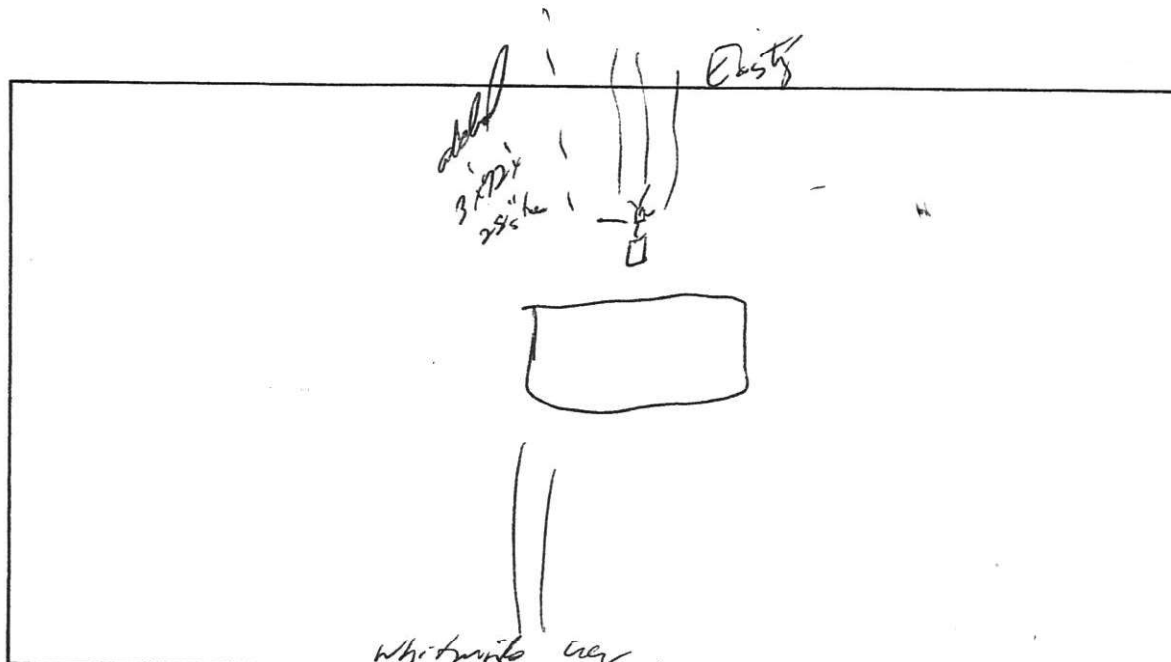

GRANVILLE-VANCE HEALTH DEPARTMENT—Sewage Disposal Record

Owner or Contractor Gary Shipley Date 9-19-95 S.R. No. NC96

Location/Address Whitwinds Way - off 905

Subdivision/Mobile Home Park Name Whitfield Chase

Lot Size 1.325A

Permit No. # 1341

Lot No. 49

New System ☒ Repair _____
House ☒ Mobile Home _____ Business _____
No. Bedrooms 3 No. People _____ No. Toilets _____
Water Supply: Private ☒ Approved _____
Semi-Public _____ Unapproved _____
Public _____ None _____

Nitrification System:

Tank Size 900 gal.

Distribution Box ☒ No. Lines 3

Nitrification Field 900 Sq. Ft.

Lines: 1 2 3 4 5 6

Width 3' 3' 3' _____

Length 74' 64' 64' _____

Grade 0" 1/2" 0" _____

Stone Depth 18" 18" 18" _____

Layout to be followed by installer:

Improvements Permit By M.E. Yount

Installer Blackley Bros.

Certificate of Completion By Christopher M. Hall

Date of Inspection 1-5-96

* Construction must comply with all other applicable state and local regulations, but the permit is not a guarantee that the system will not malfunction and the Granville-Vance Health District will not be held responsible for a malfunctioning system.

NOTE: Make sketch of installation showing location of house, septic tanks, privies, water supplies on adjacent property, etc. Write in measurements in order that installations may be located at later date.

