

GRANVILLE-VANCE HEALTH DEPARTMENT—Sewage Disposal Record

Owner or Contractor Margaret Parham / Ted Pittard Date 2-6-02 S.R. No. 1662

Location/Address Mistletoe Lane off Tabbs Creek

Subdivision/Mobile Home Park Name Twin Creek Lot Size 1.34 acres

Permit No. # 2997 Lot No. 35

New System ☒ Repair ☐

House ☒ Mobile Home ☐ Business ☐

No. Bedrooms 4 No. People 4 No. Toilets 4

Water Supply: Private ☒ Approved ☐

Semi-Public ☐ Unapproved ☐

Public ☐ None ☐

Nitrification System:

Tank Size 1000 gal.

Distribution Box ☒ No. Lines 3

Nitrification Field 1200 Sq. Ft.

Lines: 1 2 3 4 5 6

Width 3' 3' 3' _____

Length 120' 125' 132' _____

Grade 2" 2" 0" _____

Stone Depth 12" 12" 12" _____

Layout to be followed by installer:

Improvements Permit By Eddie Yount Installer Ricky Pearce


Certificate of Completion By Eddie Yount Date of Inspection 2-6-02

* Construction must comply with all other applicable state and local regulations, but the permit is not a guarantee that the system will not malfunction and the Granville-Vance Health District will not be held responsible for a malfunctioning system.

Cul-de-sac

NOTE: Make sketch of installation showing location of house, septic tanks, privies, water supplies on adjacent property, etc. Write in measurements in order that installations may be located at later date.

Misthote Lane

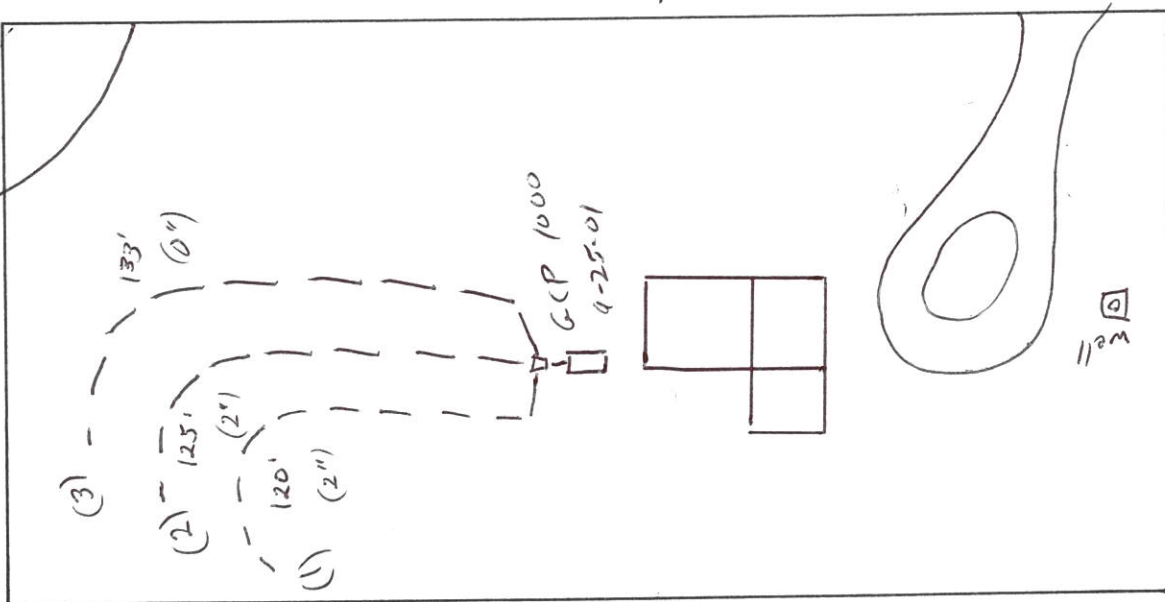

Sawmill Road

Tabbs Creek Lane

S.R. 1662