

GRANVILLE-VANCE HEALTH DEPARTMENT—Sewage Disposal Record

Owner or Contractor Wynn Construction Date _____ S.R. No. 1629
 Location/Address Brookside Lane off Flat Rock Road
 Subdivision/Mobile Home Park Name Brookside Lot Size 1.162 ac.
 Permit No. # 05210 Lot No. 2

New System ☒ Repair _____
 House ☒ Mobile Home _____ Business _____
 No. Bedrooms 3 No. People _____ No. Toilets _____
 Water Supply: Private ☒ Approved _____
 Semi-Public _____ Unapproved _____
 Public _____ None _____


Nitrification System:
 Tank Size 1000 gal.
 Distribution Box ☒ No. Lines 3
 Nitrification Field _____ Sq. Ft.
 Lines: 1, 2, 3, 4, 5, 6
 Width 3' 3' 3' _____
 Length 100' 100' 100' _____
 Grade 0' 0' 0' _____
 Stone Depth 10 10 10 _____
E 2 Flow unit,

Layout to be followed by installer:

Improvements Permit By Eddie Yount Installer Robert Blackley
 Certificate of Completion By Eddie Yount Date of Inspection 1-9-06

* Construction must comply with all other applicable state and local regulations, but the permit is not a guarantee that the system will not malfunction and the Granville-Vance Health District will not be held responsible for a malfunctioning system.

NOTE: Make sketch of installation showing location of house, septic tanks, privies, water supplies on adjacent property, etc. Write in measurements in order that instalations may be located at later date.

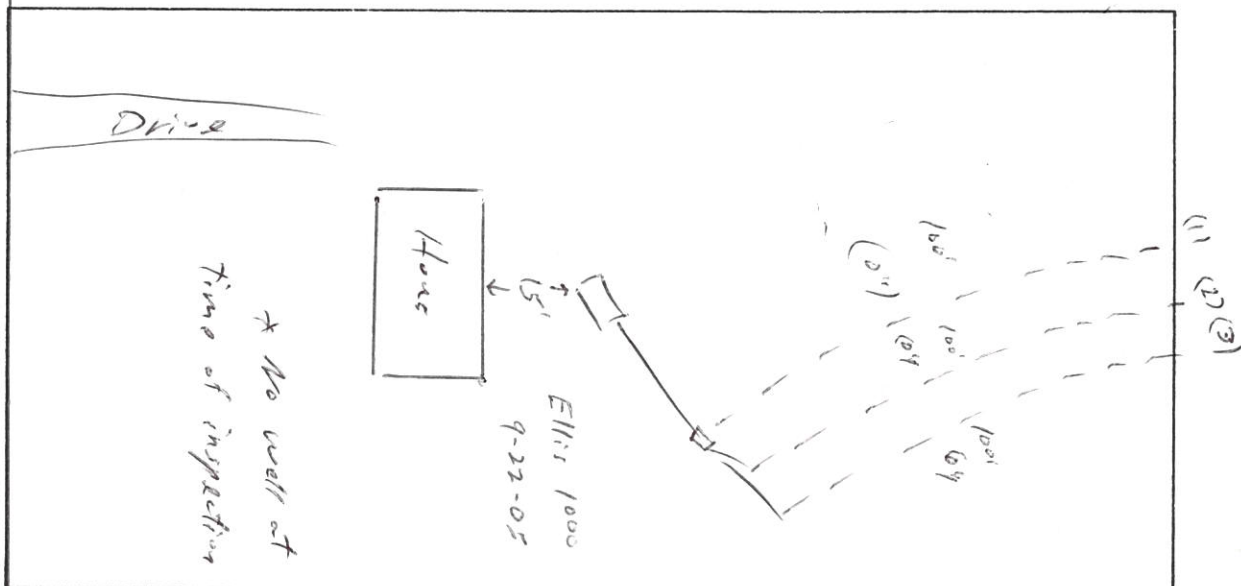

Brookdale Lane

Flat Rock Road SR 1629