

GRANVILLE-VANCE HEALTH DEPARTMENT—Sewage Disposal Record

Owner or Contractor Roy Eaker Date 7-10-00 S.R. No. 1004

Location/Address Old Nc 75 + Shock Overton Rd.

Subdivision/Mobile Home Park Name _____ Lot Size 1.37 acres

Permit No. # 2408 Lot No. _____

New System ☒ Repair ☒

House ☒ Mobile Home _____ Business _____

No. Bedrooms 3 No. People _____ No. Toilets _____

Water Supply: Private ☒ Approved _____

Semi-Public _____ Unapproved _____

Public _____ None _____

Layout to be followed by installer:

Septic Nitrification System: *pressure manifold* Tank Size 1000 gal. *pump tank 1000 gal*

Distribution Box ☒ No. Lines 3

Nitrification Field 1200 Sq. Ft.

Lines:

	1	2	3	4	5	6
Width	<u>3'</u>	<u>3'</u>	<u>3'</u>			
Length	<u>133'</u>	<u>133'</u>	<u>133'</u>			
Grade	<u>0"</u>	<u>0"</u>	<u>0"</u>			
Stone Depth	<u>12"</u>	<u>12"</u>	<u>12"</u>			

Width

Length

Grade

Stone Depth


Improvements Permit By Eddie Yount Installer Robert Blackley

Certificate of Completion By Eddie Yount Date of Inspection 7-10-00

* Construction must comply with all other applicable state and local regulations, but the permit is not a guarantee that the system will not malfunction and the Granville-Vance Health District will not be held responsible for a malfunctioning system.

Oxford

NOTE: Make sketch of installation showing location of house, septic tanks, privies, water supplies on adjacent property, etc. Write in measurements in order that installations may be located at later date.

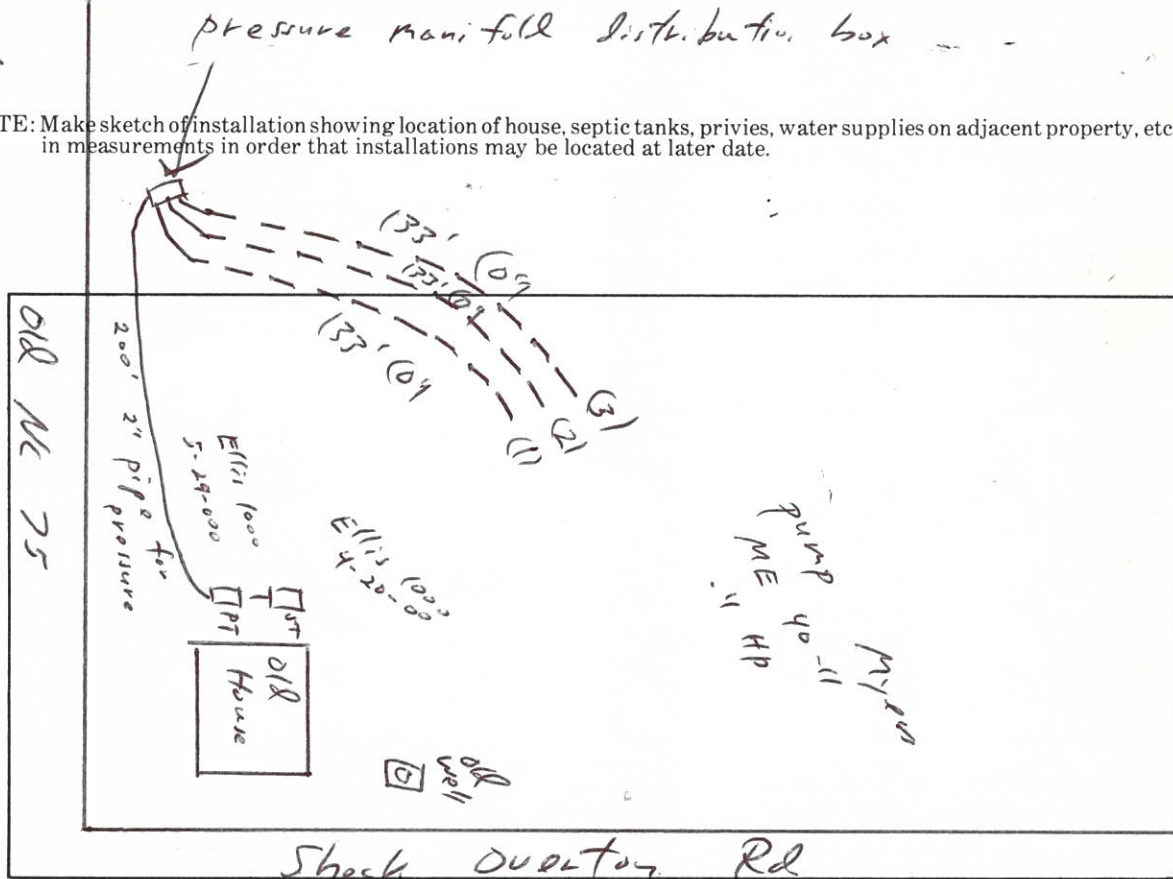

1948

Date: 9/26/16

Septic Permit #: 2408

Environmental Health Specialist: W. J. [Signature]

LS FLAGGED

Date: 9/26/16

Depth: 320 Casing Depth: 35 GPM: 3

Comments: _____

Date Completed: 7-7-07

Retest: _____ Results: _____