

PERMIT NUMBER **8153**

GRANVILLE-VANCE DISTRICT HEALTH DEPARTMENT
IMPROVEMENT AND OPERATION PERMITS

Zoning #
18583

COUNTY:	TAX NO.	TYPE OF ESTABLISHMENTS			*THIS PERMIT SHALL BE ACCOMPANIED BY A LAYOUT SHOWN ON A PLAT, INCLUDING SYSTEM REQUIREMENTS.
Granville	SR. NO.	RESIDENCE ☒	NUMBER OF BEDROOMS:	NUMBER OF OCCUPANTS:	
		BUSINESS ☐	41	8 max	
		OTHER ☐			
OWNER:		WATER SUPPLY	WELL ☒	OTHER ☐	*THIS IMPROVEMENT PERMIT IS SUBJECT TO REVOCATION IF THE INTENDED USES CHANGE FROM THOSE SHOWN ON THE IMPROVEMENT PERMIT. CHANGES SHALL REQUIRE HEALTH DEPARTMENT APPROVAL.
APPLICANT'S ADDRESS:		TYPE OF WASTEWATER SYSTEM	INITIAL INSTALLATION	REPAIR	
		DESIGN FLOW:	480 gpd	Type III g pump	
PROPERTY ADDRESS/LOCATION:		LTAR:	3 gpd/ft ²		
SUBDIVISION:		ABSORPTION AREA:	1600 ft ² → 1200 ft ²		
LOT NUMBER:		TRENCH WIDTH:	3'		
REFERENCE SKETCH (SEE PLAT FOR DETAILS)		TRENCH DEPTH:	18"-20"		
		TRENCH SPACING:	9' o.c.		
		TOTAL TRENCH LENGTH:	400'		
		NUMBER OF TRENCHES:	3		
		GRAVEL DEPTH:	Accepted		PERMIT VALID FOR: 5 YEARS YES NO
		TANK SIZE:	1000 gal		
		PUMP TANK SIZE:			NO EXPIRATION YES NO
		DISTRIBUTION DEVICE:	Distribution Box		

See Consultants' layout design
Divert all surface water away from Septic System
Stay out of drainage area

IMPROVEMENT PERMIT DATE: 3-12-15
FOR: Mc Duffie Homes
ISSUED BY: David Carter

CONSTRUCTION AUTHORIZATION FOR IMPROVEMENT PERMIT# **8153**

Unless otherwise indicated, the same conditions above apply regarding system type, layout, location and installation requirements.
(The wastewater system cannot be installed until authorization is signed)

Comments: Call 919-693-2658 w/ questions

Date: 3-12-15 Environmental Health Specialist: David Carter Construction Authorization Addendum ☐ Yes ☐ No

OPERATION PERMIT DATE: 8/24/15

SYSTEM INSTALLED BY: David Toulou
ISSUED BY: Walter Vaughan KEHS

PERFORMANCE, MONITORING, MAINTENANCE AND OPERATION
AS REQUIRED BY RULE .1961

Granville - Vance District Health Department
Environmental Health

Pin _____

Permit Number 8153

L Improvement Permit

— Construction Authorization

Final Sketch

McDuffie Homes
Applicants Name

Old Brassfield 82
Subdivision - Section - Lot

Physical Address: 654 Coughlin Ct.

David Tralove
System Installer

8/28/15
Date

System design and details as installed.

Septic Tank Information:

Date: 3-24-15

Manufacture: David Brantley

ID #: STB 646

Pump Tank Information:

Date: _____

Manufacture: NA

ID #: _____

Distribution Box ☒

Pressure Manifold _____

Serial Distribution _____


Pump Info: _____

Type of Facility: Res.

Number of Bedrooms: 4

Well Drilled: yes

Type of System: ☒ Gravity ☐ Pump ☐ Gravel ☒ Polystyrene ☐ Chamber ☐ Other: _____

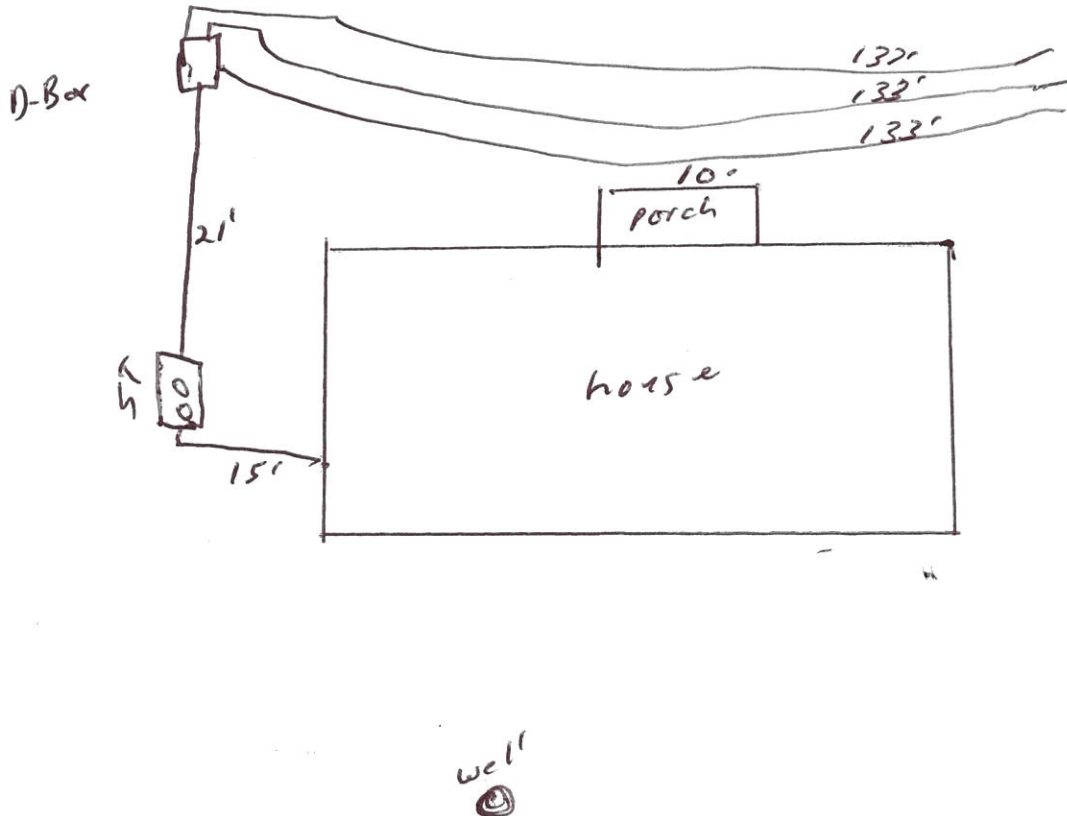

Walter P. Coughlin St. REHS
Authorized Signature

Coughlin Ct.
8/28/15
Date

Granville - Vance District Health Department

Environmental Health

1532

Well Construction Permit

Owner/Applicant: McDuffie Homes Date: 3/12/15
 Address or Location of Property: 654 Coughlin Ct.


Subdivision & Lot #: Olde Brassfield 82 Septic Permit #: 8153
 Zoning Permit #: 18583 Environmental Health Specialist: David Calum

This well permit is to locate and site the area that a private groundwater well may be established on the property listed above by the Environmental Health Specialists of Granville County. If one does not locate the well in the approved area and complete the well as specified by the 15A NCAC .02C rules, then permits may be revoked. At completion of drilling of the well, grout must be witnessed by EHS and a well log turned into Environmental Health.

Minimum Setbacks: (these are the main setbacks, but not all required setbacks)

Setback from property lines – 10 ft Setback from septic tank and drain field, including repair area – 100 ft
 Setback from structural foundations – 25 ft Setback from ponds, lakes or other bodies of water – 50 ft

Site Sketch:

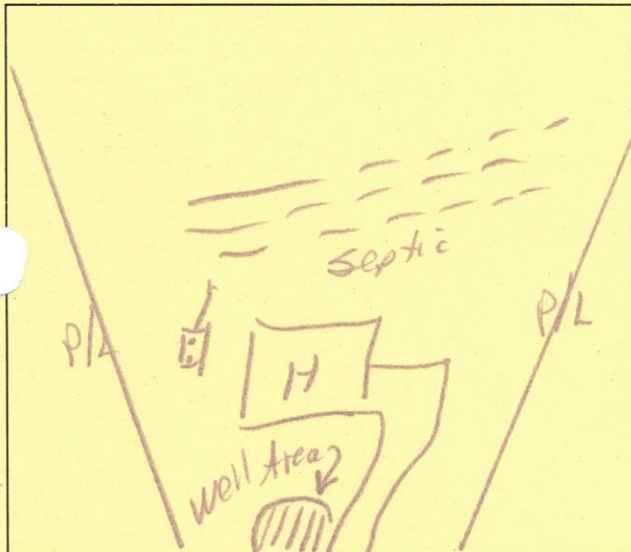

As Built Drawing:



Conditions: Call 919-693-2688
w/ questions

Authorized Agent: David Calum
Date: 3-12-15

1 Well Grout: (Circle or write in)

Witnessed: Yes or No EHS Agent: W. D. Dugan
 Date: 6-2-15 Annular Space Open: Yes or No
 Over reamed: Yes or No Depth Grouted: 20+
 Method: Pump ☒ Poured Pressure
 Well Log received: Yes or No (EHS to Attach to Permit)
 Driller Name: Southern Cert. # 4165
 Depth: 500' Casing Depth: 95' GPM: 4

2 Well Final: (Place a check mark when finalized)

Seal Present and Intact: ☒ Air Vent: ☒
 Hose Spigot: ☒ Electrical Box: ☒
 Pump Installer Tag: ☒ Well Installer Tag: ☒
 All holes sealed: ☒ 12" above grade: ☒
Comments:

3 Well Completion Permit: W. D. Dugan EHS
Date Completed: 8/28/15

4 Water Samples Taken: Date: 10/27/15
 EHS: W. D. Dugan NTB Results:
 Retest: Results: