

# GRANVILLE-VANCE HEALTH DEPARTMENT—Sewage Disposal Record

Owner or Contractor Steven Hayer Date 2-23-07 S.R. No. 1717  
 Location/Address Belmont Circle off Woodland Church Rd  
 Subdivision/Mobile Home Park Name Fieldstone West Lot Size .918 ac  
 Permit No. # 05812 Lot No. 61

New System ☒ Repair \_\_\_\_\_  
 House ☒ Mobile Home \_\_\_\_\_ Business \_\_\_\_\_  
 No. Bedrooms 4 No. People \_\_\_\_\_ No. Toilets \_\_\_\_\_  
 Water Supply: Private ☒ Approved \_\_\_\_\_  
 Semi-Public \_\_\_\_\_ Unapproved \_\_\_\_\_  
 Public \_\_\_\_\_ None \_\_\_\_\_

## Nitrification System:

Tank Size 1000 gal. No. Lines 3  
 Distribution Box ☒ No. Lines \_\_\_\_\_  
 Nitrification Field 1600 Sq. Ft.

| Lines:      | 1           | 2           | 3           | 4 | 5 | 6 |
|-------------|-------------|-------------|-------------|---|---|---|
| Width       | <u>3'</u>   | <u>3'</u>   | <u>3'</u>   |   |   |   |
| Length      | <u>130'</u> | <u>135'</u> | <u>135'</u> |   |   |   |
| Grade       | <u>0"</u>   | <u>0"</u>   | <u>0"</u>   |   |   |   |
| Stone Depth | <u>13</u>   | <u>13.5</u> | <u>13.5</u> |   |   |   |


E2 Flow unit,

Layout to be followed by installer:

Improvements Permit By Eddie Yount Installer David Brantley & Sons  
 Certificate of Completion By Eddie Yount Date of Inspection 2-23-07

\* Construction must comply with all other applicable state and local regulations, but the permit is not a guarantee that the system will not malfunction and the Granville-Vance Health District will not be held responsible for a malfunctioning system.

NOTE: Make sketch of installation showing location of house, septic tanks, privies, water supplies on adjacent property, etc. Write in measurements in order that installations may be located at later date.

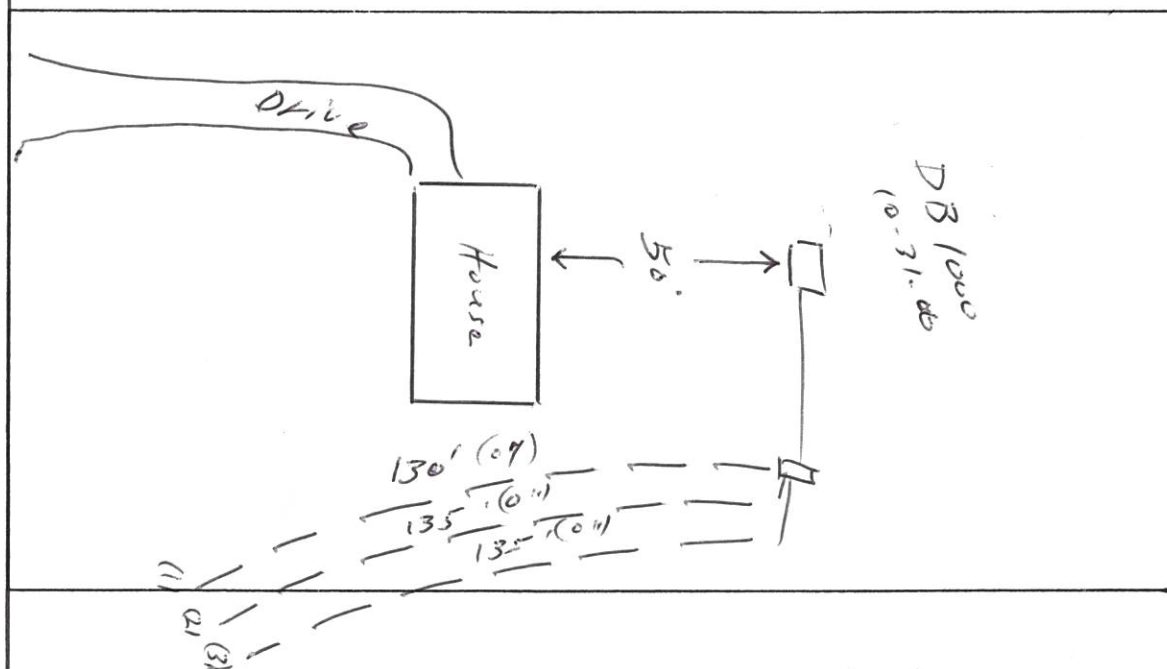

Belmont Circle

Woodland Church Road S.R. 1717