

GRANVILLE-VANCE DISTRICT HEALTH DEPARTMENT IMPROVEMENT AND OPERATION PERMITS

COUNTY: <u>Granville</u>	TAX NO.	TYPE OF ESTABLISHMENTS			*THIS PERMIT SHALL BE ACCOMPANIED BY A LAYOUT SHOWN ON A PLAT, INCLUDING SYSTEM REQUIREMENTS. *THIS IMPROVEMENT PERMIT IS SUBJECT TO REVOCATION IF THE INTENDED USES CHANGE FROM THOSE SHOWN ON THE IMPROVEMENT PERMIT. CHANGES SHALL REQUIRE HEALTH DEPARTMENT APPROVAL.
	SR. NO.	RESIDENCE ☒ BUSINESS ☐ OTHER ☐	NUMBER OF BEDROOMS: <u>4</u>	NUMBER OF OCCUPANTS: <u>8 MAX</u>	
APPLICANT: <u>Traditions Builders</u>	WATER SUPPLY	WELL ☒ PUBLIC ☐	OTHER ☐		
APPLICANT'S NAME & ADDRESS:	TYPE OF WASTEWATER SYSTEM	INITIAL INSTALLATION <u>TLG</u>	REPAIR		
PROPERTY ADDRESS/LOCATION: <u>Hillcrest Way</u>	DESIGN FLOW:	<u>480 gpd</u>			
SUBDIVISION: <u>Windsor Lakes</u>	LTAR:	<u>.3 gpd/sq ft</u>			
LOT NUMBER: <u>48</u>	ABSORPTION AREA:	<u>1,200 sq ft</u>			
REFERENCE SKETCH (SEE PLAT FOR DETAILS) * Risers on tank * Stay as close to house with line as possible. (6')	TRENCH WIDTH:	<u>36"</u>			
	TRENCH DEPTH:	<u>18-20"</u>			
	TRENCH SPACING:	<u>9' o.c.</u>			
	TOTAL TRENCH LENGTH:	<u>400'</u>			
	NUMBER OF TRENCHES:	<u>3</u>			
	GRAVEL DEPTH:	<u>N/A</u>			
	TANK SIZE:	<u>1000 gal</u>			
	PUMP TANK SIZE:	<u>N/A</u>			
	DISTRIBUTION DEVICE:	<u>D-Box</u>			PERMIT VALID FOR: 5 YEARS YES ☒ NO ☐
					NO EXPIRATION YES ☐ NO ☒

IMPROVEMENT PERMIT

 DATE: 1/10/18

FOR:

ISSUED BY:

CONSTRUCTION AUTHORIZATION FOR IMPROVEMENT PERMIT#

Unless otherwise indicated, the same conditions above apply regarding system type, layout, location and installation requirements.
(The wastewater system cannot be installed until authorization is signed)

Comments:

Date:

1/10/18

Environmental Health Specialist:

Adelma Corwin

Construction Authorization Addendum

☒ Yes ☐ No

OPERATION PERMIT

DATE:

Tank 5-30-18 (AWC)
6-5-18

SYSTEM INSTALLED BY:

Brantley

ISSUED BY:

Adelma Corwin

**PERFORMANCE, MONITORING, MAINTENANCE AND OPERATION
AS REQUIRED BY RULE .1961**

Granville-Vance District Health Department

Environmental Health

PIN _____

Final Sketch

Date 6-5-18

Tradikons Builder

Applicant's Name

9283

Permit No.

Windsor Lakes/48

Subdivision/Lot Number


Physical Address: Hillcrest Way

Brantley

System Installer

[Signature]

Authorized Signature

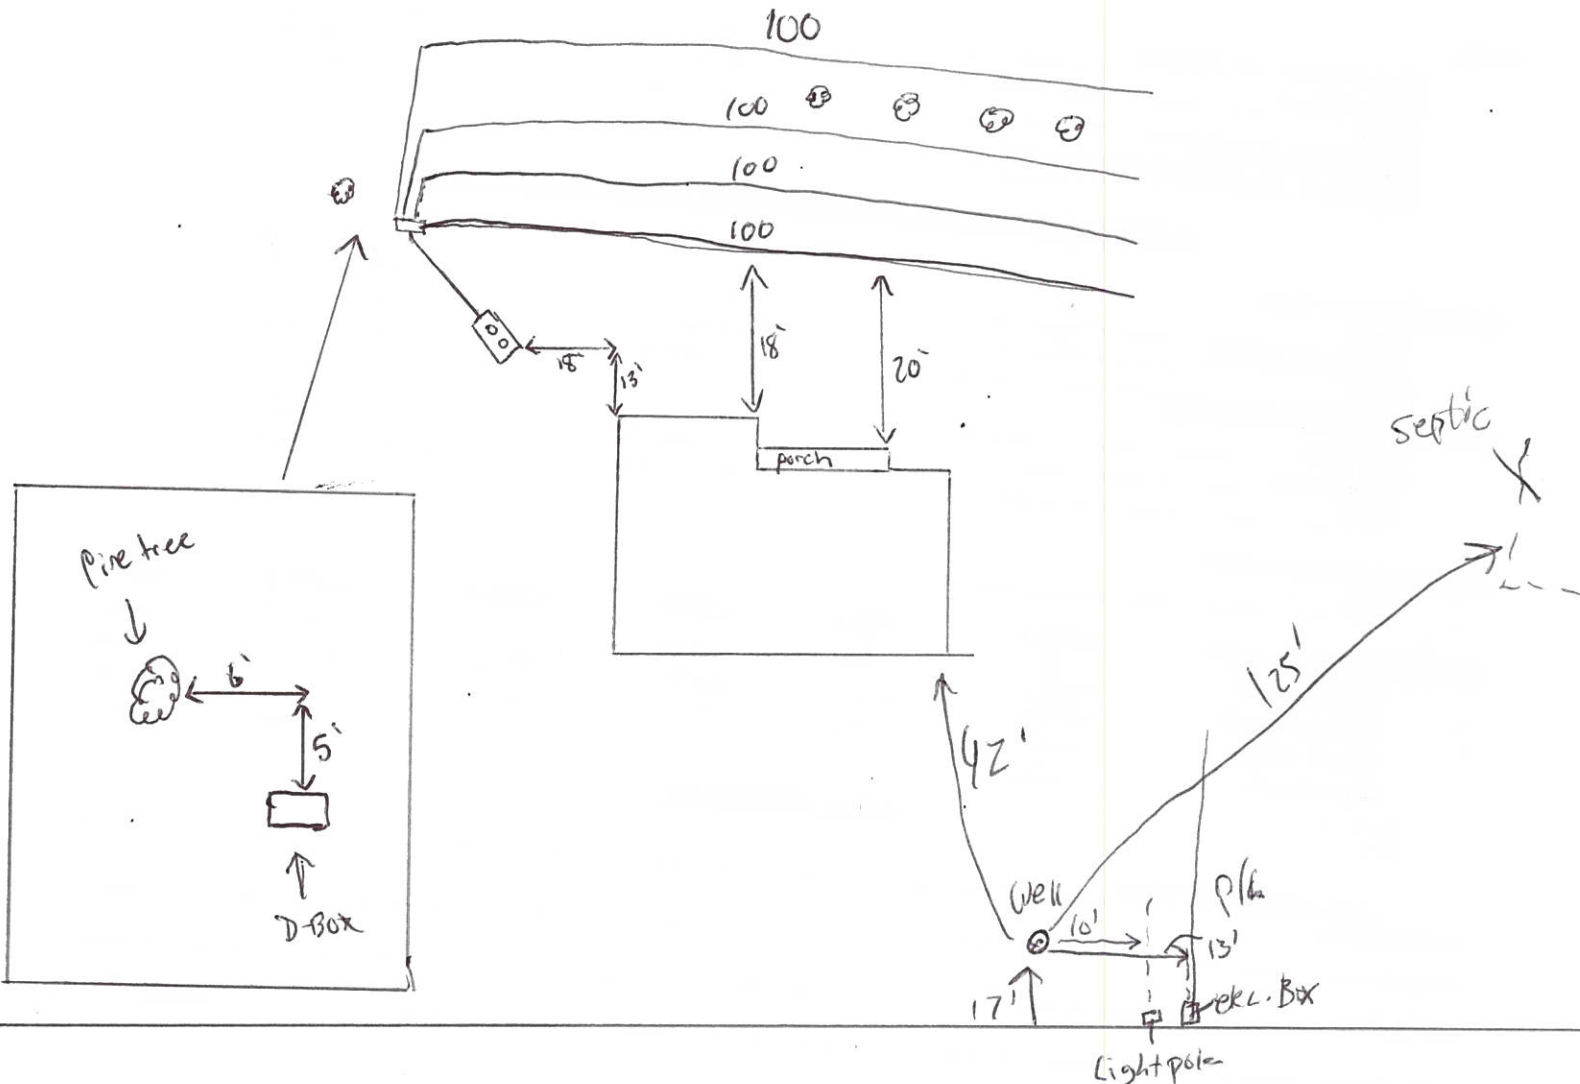

SEWAGE DISPOSAL SYSTEM INSTALLATION REVIEW

SEPTIC AND PUMP TANK INSPECTION

SEPTIC TANK

Manufacturer DB
 Date of Manufacture 3-6-18
 Stamp STB-502
 Capacity 1000
 Tee ☒
 Baffle ☒
 Sealant ☒
 AIR GAP ☒ FILTER ☒ RISER ☒

INITIAL
awc

DATE
5-30-18

PUMP TANK

Manufacture _____
 Date of Manufacture _____
 Stamp _____
 Capacity _____
 Sealant _____
 Manhole _____
 RISER _____ SEALANT _____

MECHANICAL INSPECTION

PUMP

Manufacturer and Model # _____
 Control Panel _____
 Alarm _____
 Electrical Connection _____
 SEALANT AROUND CONDUIT _____

NITRIFICATION/DISTRIBUTION AND DRAINFIELD INSPECTION

DISTRIBUTION BOX

Level ☒
 Equal Distribution ☒
 Other _____

DISTRIBUTION MANIFOLD

Pipe Size _____
 Gate Valves _____
 Other _____

OTHER DISTRIBUTION

Type _____

NITRIFICATION LINES

Trench Width _____
 Trench Length _____
 Trench Grade _____
 Stone Depth _____

LINE 1
3'
100'
✓
-

LINE 2
3'
100'
✓
-

LINE 3
3'
100'
✓
-

LINE 4
3'
100'
✓
-

LINE 5

LINE 6

WELL INSPECTION

LOCATION OF WELL

COMMENTS:

EZ-Flow