

GRANVILLE-VANCE HEALTH DEPARTMENT—Sewage Disposal Record

Owner or Contractor Eugene Evans Date 6-28-08 S.R. No. 1718
 Location/Address Nottingham Drive off Rock Springs Church Rd.
 Subdivision/Mobile Home Park Name _____ Lot Size 5.7 acres
 Permit No. # 06371 Lot No. _____

New System ☒ Repair _____
 House _____ Mobile Home DM Business _____
 No. Bedrooms 4 No. People 2 No. Toilets _____
 Water Supply: Private ☒ Approved _____
 Semi-Public _____ Unapproved _____
 Public _____ None _____

Nitrification System:
 Tank Size 1000 gal.
 Distribution Box ☒ No. Lines 4
 Nitrification Field 1600 Sq. Ft.
 Lines: 1 2 3 4 5 6
 Width 3' 3' 3' 3' _____
 Length 100' 100' 100' 100' _____
 Grade 0" 0" 0" 0" _____
 Stone Depth 10 10 10 10 _____


Layout to be followed by installer:

EZ Flow units

Improvements Permit By David Cumbee Installer Chris Milk
 Certificate of Completion By Eddie Yount Date of Inspection 6-28-07

* Construction must comply with all other applicable state and local regulations, but the permit is not a guarantee that the system will not malfunction and the Granville-Vance Health District will not be held responsible for a malfunctioning system.

NOTE: Make sketch of installation showing location of house, septic tanks, privies, water supplies on adjacent property, etc. Write in measurements in order that installations may be located at later date.

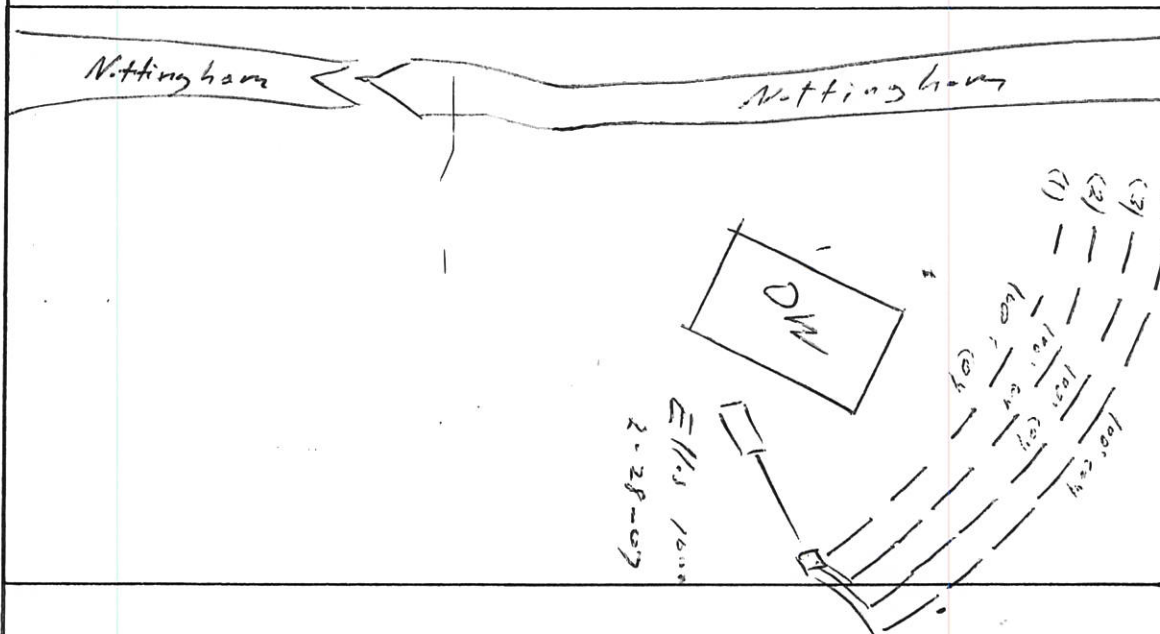

EZ Flow

Rock Springs Church Rd SR 1718

Rice Avenue Rd