

Granville - Vance District Health Department
Environmental Health

Per

183300026605

Permit Number 6768

Improvement Permit

Construction Authorization

Final Sketch

G. Payson Homes
Applicants Name

Fieldstone West 48
Subdivision - Section Lot

Physical Address:

Belmont Circle

David Brantley & Sons
System Installer

7-29-09
Date

System design and details as installed.

Septic Tank Information:

Date: 7-02-03

Manufacturer: D+13 1200 gal

ID #: STB 34

Pump Tank Information:

Date:

Manufacturer:

ID #:

Distribution Box ☒


Pressure Manifold ☐

Serial Distribution ☐

Type of Facility: house

Number of Bedrooms: 4

Type of System: gravity → E-2 flow

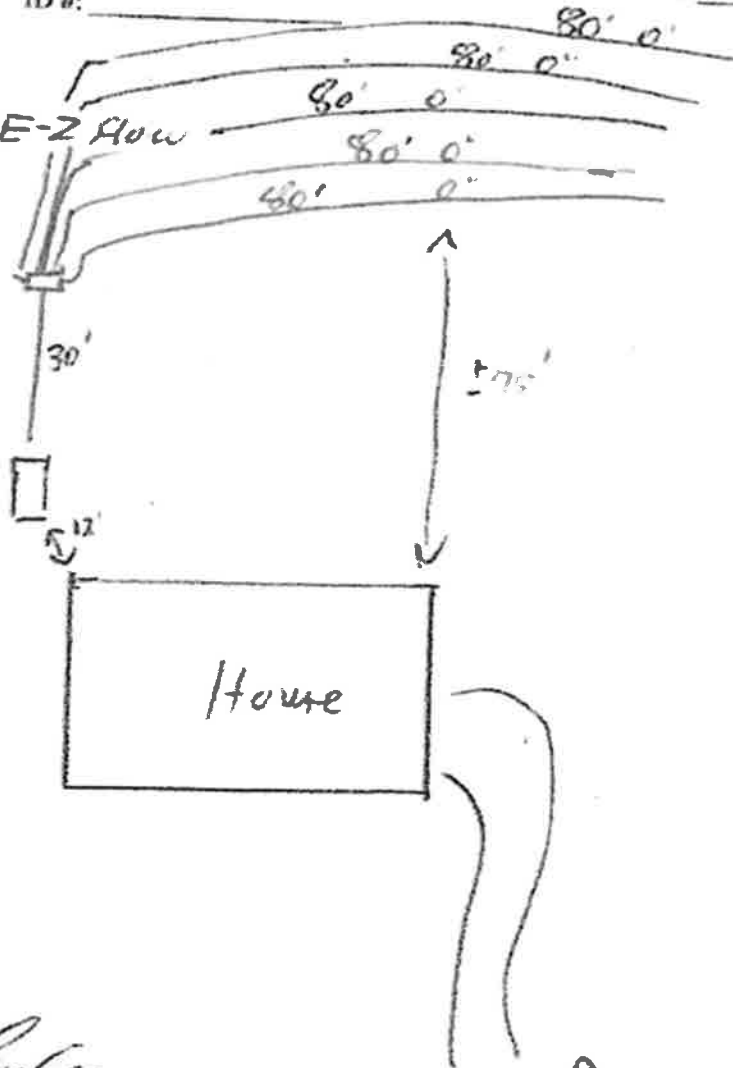

David Brantley
Authorized Signature

7-29-09
Date