

GRANVILLE-VANCE HEALTH DEPARTMENT—Sewage Disposal Record

0973 Owner or Contractor Julius & Judy Mayse Date June 8 S.R. No. NC 96

Location/Address Route #3 Oxford N.C.

Subdivision/Mobile Home Park Name James Carrin

Lot Size 2.69 ac.

Lot No. 1

New System ☒ Repair ☐

House ☐ Mobile Home ☒ Business ☐

No. Bedrooms 3 No. People 2 No. Toilets 2

Water Supply: Private ☒ Approved ☐

Semi-Public ☐ Unapproved ☐

Public ☐ None ☐

Nitrification System:

Tank Size 900 gal.

Distribution Box yes No. Lines 2

Nitrification Field 320' - 960' Sq. Ft.

Lines:	1	2	3	4	5	6
Width	<u>36"</u>	<u>36"</u>				
Length	<u>160'</u>	<u>165'</u>				
Grade	<u>50</u>	<u>50</u>				
Stone Depth	<u>12"</u>	<u>12"</u>				

Layout to be followed by installer:


MB 11 P 92

Improvements Permit By Bobby E. Greene Installer Charles Adcock

Certificate of Completion By Bobby E. Greene Date of Inspection June 29, 1988

* Construction must comply with all other applicable state and local regulations, but the permit is not a guarantee that the system will not malfunction and the Granville-Vance Health District will not be held responsible for a malfunctioning system.

NOTE: Make sketch of installation showing location of house, septic tanks, privies, water supplies on adjacent property, etc. Write in measurements in order that installations may be located at later date.

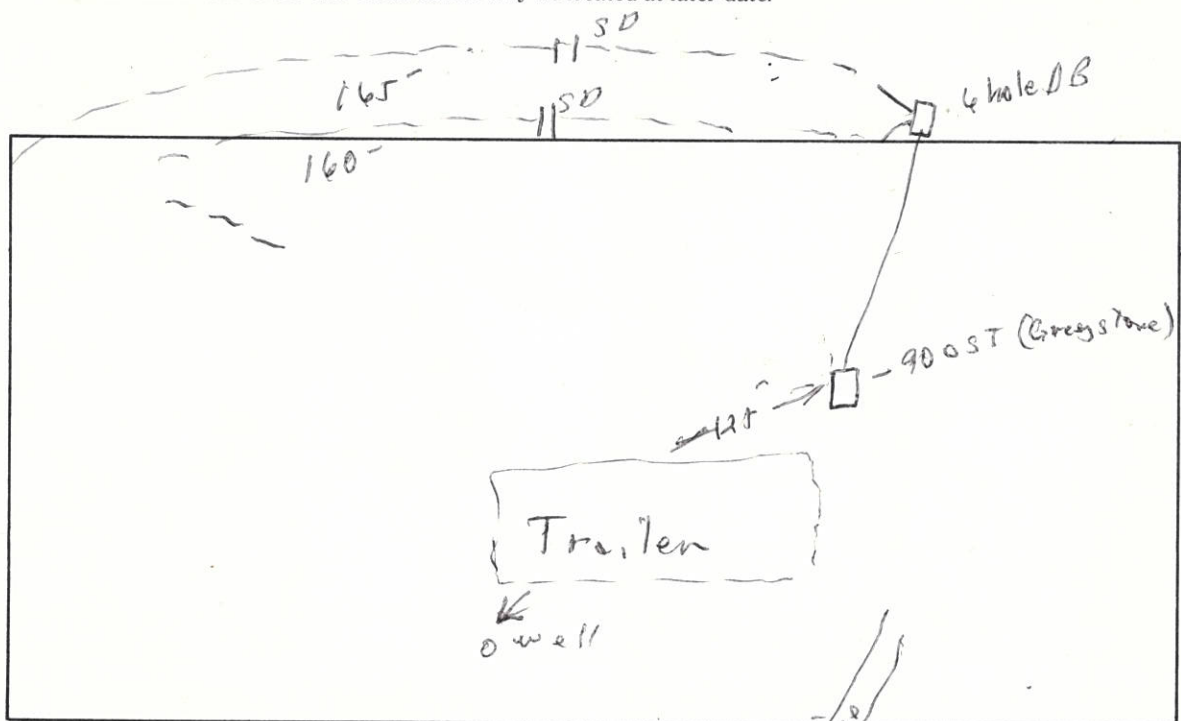

AC 96 → 0 x 10