

IMPROVEMENT PERMIT

Granville County Health Dept
Environmental Health
101 Hunt Drive
Oxford, NC 27565
Phone: (252) 492-5263 Fax: (252) 492-2361

For Office Use Only

*CDP File Number _____
County ID Number: 182400298230
Evaluated For: NEW

PERMIT VALID UNTIL: 08/25/2025

*NOTE TO INSPECTIONS DIVISION: Building Permits cannot be issued with this Improvement Permit

Applicant: Valenti Homes
Address: 14916 Coveshore Dr
City: Wake Forest
State/Zip: NC 27587
Phone #: home: (919) 809-4044

Property Owner: Valenti Homes
Address: 14916 Coveshore Dr
City: Wake Forest
State/Zip: NC 27587
Phone #: home: (919) 809-4044

Property Location & Site Information			
Address/Road #:	3543	Subdivision:	Preserve at
	27587	Directions:	Smith Creek
Structure:	SINGLE FAMILY	Off of Bruce Garner Rd	
# of Bedrooms:	4		
# of People:			
*Water Supply:	NEW WELL		

Initial System		System Specifications	
*Site Classification:	Provisionally Suitable	Minimum Trench Depth:	18 Inches
Design Flow:	480	Maximum Trench Depth:	22 Inches
Soil Application Rate:	0.2750	Septic Tank:	1000 Gallons
*System Classification/Description:	TYPE III G. OTHER NON-CONV. TRENCH SYSTEMS	Pump Required:	☐ Yes ☒ No ☐ May Be Required
*Proposed System:	25% REDUCTION	Pump Tank:	_____ Gallons

Repair System Required: ☒ Yes ☐ No ☐ No, but has Available Space

Repair System		System Specifications	
*Site Classification:	Provisionally Suitable	Minimum Trench Depth:	_____ Inches
Soil Application Rate:		Maximum Trench Depth:	_____ Inches
*System Classification/Description:	TYPE III E. PPBPS GRAVITY DOSED SYSTEM	Pump Required:	☐ Yes ☒ No ☐ May Be Required
*Proposed System:	50% REDUCTION	Pump Tank:	_____ Gallons

No grading or construction activity is allowed in areas designated for system and repair without approval of Health Department

*Site Modifications

The issuance of this permit by the Health Department in no way guarantees the issuance of other permits. The permit holder is responsible for checking with appropriate governing bodies in meeting their requirements.

*Permit Conditions

Serial distribution system/Stay off all easements with any part of septic/Min. 10' off property lines with drainlines and "D" Box/System (Initial/Repair) Laid out in field by REHS/Min. 10' off house foundation (downslope setback)/50' min off wells

The Department and Local Health Department may impose conditions on the issuance and may revoke the permits for failure of the system to satisfy the conditions, the rules, or this article. This permit is subject to revocation if the site plan, plat, or intended use changes (NCGS 130A-335(f)). The person owning or controlling the system location, installing, operation, maintenance, monitoring, monitoring and repair (193B/11)

Authorized State Agent:

Bullock, Will *Will Bullock*

Date of Issue: 08/25/2020

Total Time: (HH MM)

☒ Hand Drawing

☐ Import Drawing

Site Plan/Drawing attached.



Construction Authorization

Granville County Health Dept
Environmental Health

101 Hunt Drive
Oxford, NC 27565

Phone: (252) 492-5263 Fax: (252) 492-2361

For Office Use Only

*CDP File Number 328158 - 1
County ID Number 182400298230
Evaluated For: NEW

PERMIT VALID UNTIL: 08/25/2025

☐ Open Pump System Sheet

Applicant: Valent Homes
Address: 14916 Coveshore Dr
City: Wake Forest
State/Zip: NC 27587
Phone #: home (919) 809-4044

Property Owner: Valent Homes
Address: 14916 Coveshore Dr
City: Wake Forest
State/Zip: NC 27587
Phone #: home (919) 809-4044

Property Location & Site Information

Address/Road #: 3593
Carole Ct Wake Forest, NC 27587 Subdivision: Preserve at Smith Creek Phase: NEW Lot: 199

Structure: SINGLE FAMILY Directions: Off of Bruce Garner Rd

of Bedrooms: 4

of People: _____

*Water Supply: NEW WELL

System Specifications

*Site Classification: Provisionally Suitable Minimum Trench Depth: 18 Inches
Design Flow: 480 Maximum Trench Depth: 22 Inches
Soil Application Rate: 0.2750 Minimum Soil Cover: _____ Inches

*System Classification/Description: TYPE III G OTHER NON-CONV TRENCH SYSTEMS Maximum Soil Cover: _____ Inches

*Proposed System: 25% REDUCTION *Distribution Type: GRAVITY - SERIAL

Nitrification Field: 1309 Sq. ft. Pump Required: ☐ Yes ☒ No ☐ May Be Required
No. Drain Lines: 1 ☐ Inches O.C. Pump Tank: _____ Gallons
Total Trench Length: 440 ft. ☒ Feet O.C. Grease Trap: _____ Gallons
Trench Spacing: 9 - ☐ Inches
Trench Width: 3 - ☒ Feet Septic Tank Installer: ☐ I ☒ II ☐ III ☐ IV
Aggregate Depth: _____ inches Grade Level Required: ☐ I ☒ II ☐ III ☐ IV

The issuance of this permit by the Health Department in no way guarantees the issuance of other permits. The permit holder is responsible for checking with appropriate governing bodies in meeting their requirements.

*Permit Conditions:

Serial distribution system/Stay off all easements with any part of septic/Min. 10' off property lines with drainlines and "D" Box/System (Initial/Repair) Laid out in field by REHS/Min. 10' off house foundation (downslope setback)/50' min off wells

The Authorization for Wastewater System Construction shall be valid for a period equal to the period of validity of the Improvement Permit and may be issued at the same time the Improvement Permit issued (NCGS 130A-336(b)). If the installation has not been completed during the period of validity of the Construction Permit, the information submitted in the application for a permit or Construction Authorization shall become invalid, and may be suspended or revoked (1937(g)). The person owning or controlling the system shall be responsible for assuring compliance with the laws, rules, and permit conditions regarding system location, installation, operation, maintenance, monitoring, reporting.

Authorized State Agent: Bullock, Will *Will Bullock*

Date of Issue: 08/25/2020

Site Plan/Drawing attached.

Total Time: (HH:MM) _____

☒ Hand Drawing ☐ Import Drawing

Granville-Vance District Health Department
Environmental Health

Pin _____

☒ Improvement Permit

Permit Number Ctp8 5-328155

☒ Construction Authorization W-228733

Site Sketch

Valenti Homes (Jay Valenti)
Applicants Name

3593 Carde Ct./Preserve 199

Subdivision - Section - Lot

Wierzbicki
Authorized State Agent

8/25/20

Date


System components represent approximate contours only. The contractor must flag the system prior to beginning the installation to insure that proper grade is maintained.

NOTES

- * Keep drain lines and 10" BOX min. 10' off property lines
- * Stay off all easements w/ septic & well
- * Drain lines min. 10' off house foundation (downslope setback)

KEY

- Initial lines
- - - Repair lines
- o proposed well location

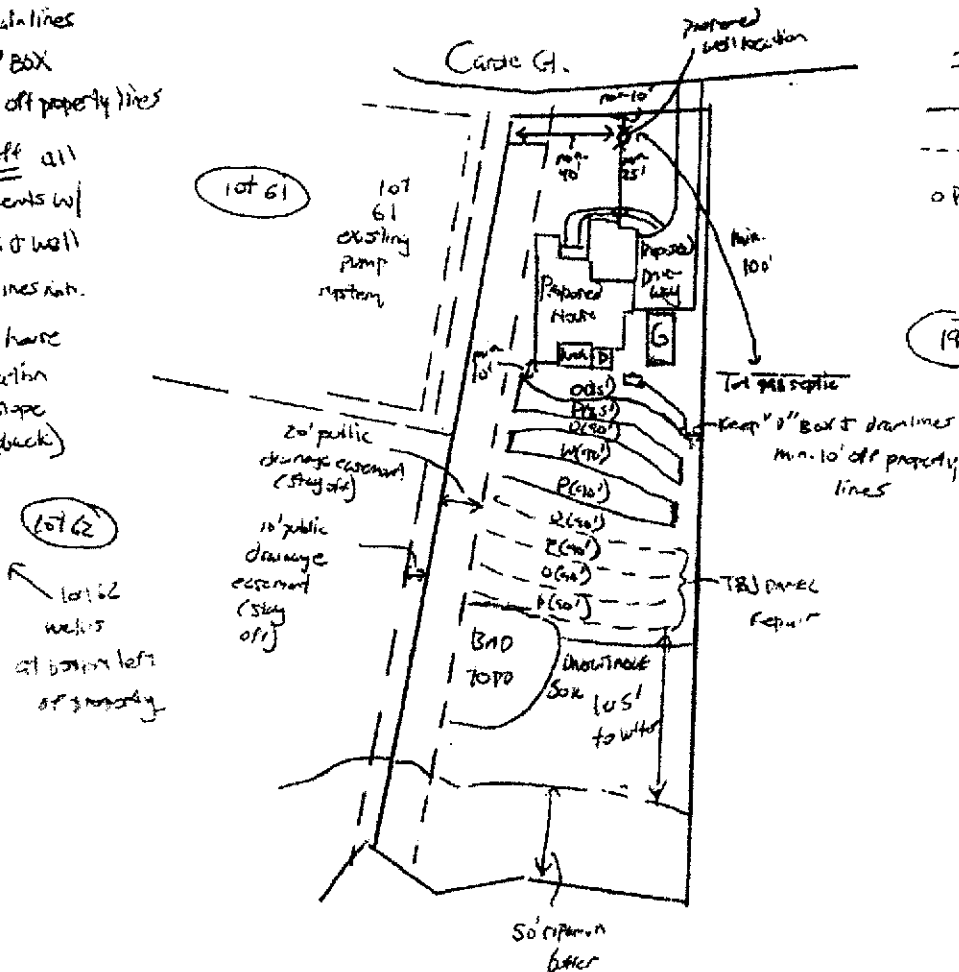

Signature

Wierzbicki

Date 8/25/20