

File Friday Layout on Robert Blackley for pd
 Pump system shallow At-grade PERMIT NUMBER 1727 1926

**GRANVILLE - VANCE DISTRICT HEALTH DEPARTMENT
 IMPROVEMENT AND OPERATION PERMITS**


COUNTY:	TAX NO.	TYPE OF ESTABLISHMENT			*THIS PERMIT SHALL BE ACCOMPANIED BY A LAYOUT SHOWN ON A PLAT, INCLUDING SYSTEM REQUIREMENTS.
Granville	SR. NO. 1727	RESIDENCE ☒	NUMBER OF BEDROOMS: 3	NUMBER OF OCCUPANTS: 2	
OWNER: Lisa + David Oakley		BUSINESS ☐			
		OTHER ☐			
APPLICANT: Patrick Hurley		WATER SUPPLY			*THE IMPROVEMENTS PERMIT MUST BE ATTACHED TO A CONSTRUCTION AUTHORIZATION BEFORE OBTAINING BUILDING PERMIT OR OTHER CONSTRUCTION PERMITS AND BEFORE A WASTEWATER SYSTEM IS INSTALLED.
1150 Fleming Road APPLICANT'S ADDRESS: Creedmore NC 27522		PUBLIC ☐	WELL ☒	OTHER ☐	
PROPERTY ADDRESS/LOCATION: Fleming Rd		TYPE OF WASTEWATER SYSTEM			
		DESCRIPTION	INITIAL INSTALLATION ☒	REPAIR	
SUBDIVISION: David + Lisa Oakley		DESIGN FLOW:	360 gal/day		*THIS IMPROVEMENT PERMIT IS SUBJECT TO REVOCATION IF THE INTENDED USE CHANGES FROM THOSE SHOWN ON THE IMPROVEMENT PERMIT. CHANGES SHALL REQUIRE HEALTH DEPARTMENT APPROVAL.
LOT NUMBER: 4A		LTAR:	1.3		
REFERENCE SKETCH (SEE PLAT FOR DETAILS) See sketch on back. Dig trenches 12" deep level on contour. Stay at least 5' from house, 10' from property line + 100' from any well. Do not install on rain.		ABSORPTION AREA:	1200 sq. ft.		
		TRENCH WIDTH:	3'		
		TRENCH SPACING:	9' on center		
		TOTAL TRENCH LENGTH:	400 ft.		
		NUMBER OF TRENCHES:	3-4		
		GRAVEL DEPTH:	12"		
		TANK SIZE: 300 gal. pump tank	1000 gal.		
		CONDITIONS: Pressure Monitor & P-Box			
IMPROVEMENT PERMIT				DATE:	
FOR: Patrick Hurley				6-15-99	
ISSUED BY: M.E. Gount R.S.					
OPERATION PERMIT				DATE:	
SYSTEM INSTALLED BY: Robert Blackley				3-6-2000	
ISSUED BY: David Cumbee					

Lot No. 4A

Stone Depth	12'	12'	12'			
-------------	-----	-----	-----	--	--	--

* sketch on back

* Construction must comply with all other applicable state and local regulations, but the permit is not a guarantee that the system will not malfunction and the Granville-Vance Health District will not be held responsible for a malfunctioning system.

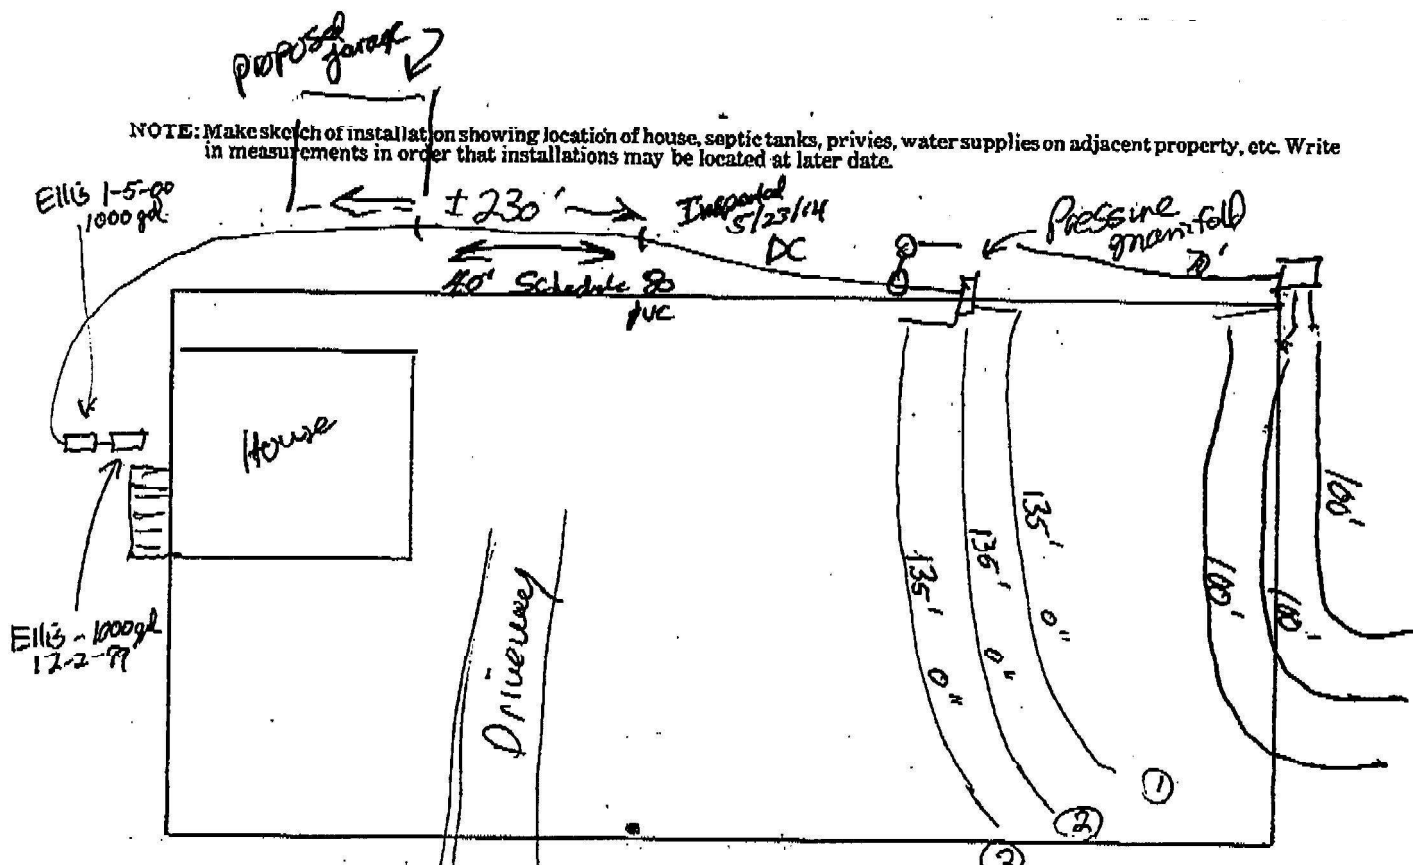


Large Layout on Back Robert Blackley
2:00

PERMIT NUMBER 3971

E-2 Flow

GRANVILLE-VANCE DISTRICT HEALTH DEPARTMENT IMPROVEMENT AND OPERATION PERMITS

COUNTY:	TAX NO.	TYPE OF ESTABLISHMENT			*THIS PERMIT SHALL BE ACCOMPANIED BY A LAYOUT SHOWN ON A PLAT, INCLUDING SYSTEM REQUIREMENTS.
Granville	SR. NO. 1727	RESIDENCE ☒ BUSINESS ☐ OTHER ☐	NUMBER OF BEDROOMS: 3	NUMBER OF OCCUPANTS: 3	
OWNER: Chris Morrissey					
APPLICANT: Chris Morrissey		WATER SUPPLY			
APPLICANT'S ADDRESS: 1141 Fleming Rd Cincinnati, OH 45222		PUBLIC ☐	WELL ☒	OTHER ☐	*THE IMPROVEMENTS PERMIT MUST BE ATTACHED TO A CONSTRUCTION AUTHORIZATION BEFORE OBTAINING BUILDING PERMIT OR OTHER CONSTRUCTION PERMITS AND BEFORE A WASTEWATER SYSTEM IS INSTALLED.
PROPERTY ADDRESS/LOCATION: 1141 Fleming Rd		TYPE OF WASTEWATER SYSTEM			
		DESCRIPTION	INITIAL INSTALLATION	REPAIR ☒	
SUBDIVISION:		DESIGN FLOW:		360 gpm/1.1	
LOT NUMBER: 4A		LTAR:		.3	
REFERENCE SKETCH (SEE PLAT FOR DETAILS) See sketch on back. Dig trenches 18" x 24" deep least on contour. Stay at least 10' from property line. Do not install or call for inspecting in rain. Connect existing line field to new line till with 3/4" Run valve. Cut off and block line that empties to surface		ABSORPTION AREA:		1200 sq. ft.	
		TRENCH WIDTH:		3'	
		TRENCH SPACING:		9' on center	
		TOTAL TRENCH LENGTH:		400 ft.	
		NUMBER OF TRENCHES:		4 @ 100 ft. each	
		GRAVEL DEPTH:		12'	
		TANK SIZE:		existing	*THIS IMPROVEMENT PERMIT IS SUBJECT TO REVOCATION IF THE INTENDED USES CHANGE FROM THOSE SHOWN ON THE IMPROVEMENT PERMIT. CHANGES SHALL REQUIRE HEALTH DEPARTMENT APPROVAL.
		CONDITIONS:	Pressure Manifold distribution box		
IMPROVEMENT PERMIT		DATE:		2-24-05	
FOR: Chris Morrissey		ISSUED BY: M.E. Gwalt, R.E.			
OPERATION PERMIT		DATE:		5-5-05	
SYSTEM INSTALLED BY: Robert Blackley		ISSUED BY: Jimmy B. Clayton			

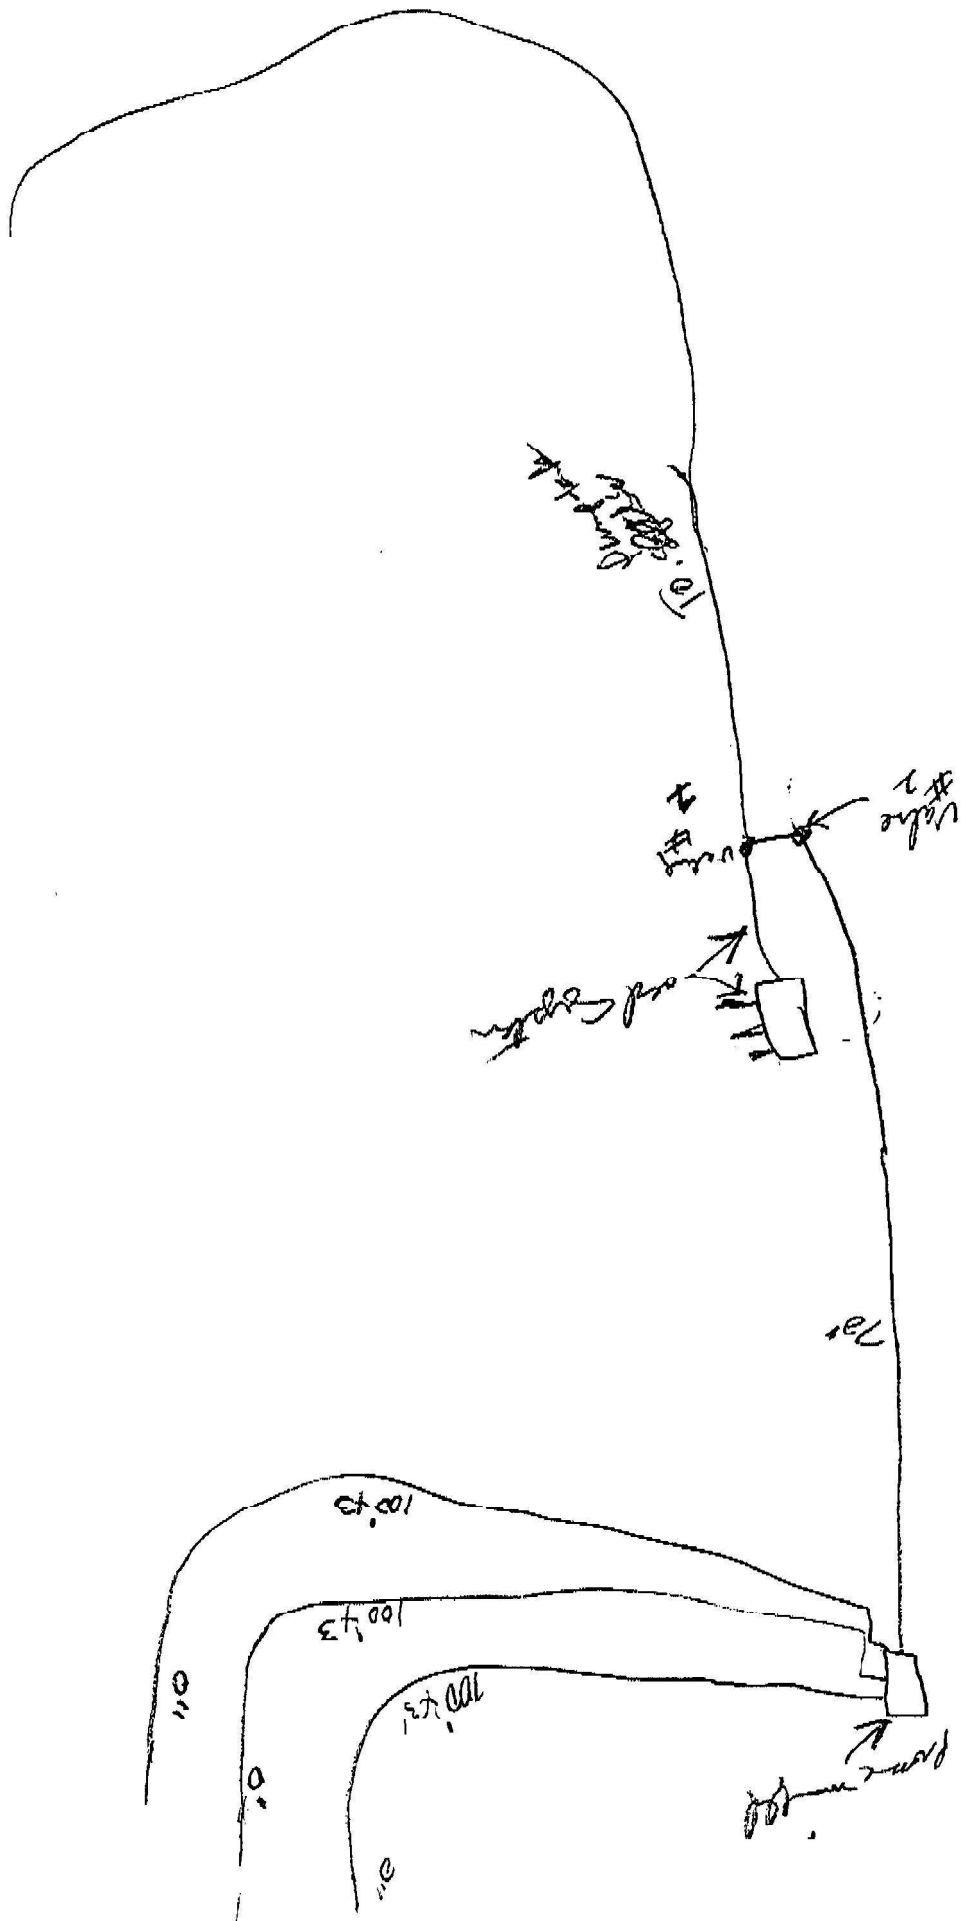

PERMIT NUMBER **07775**GRANVILLE-VANCE DISTRICT HEALTH DEPARTMENT
IMPROVEMENT AND OPERATION PERMITS

Zoning #

18208

COUNTY:	TAX NO.	TYPE OF ESTABLISHMENTS			*THIS PERMIT SHALL BE ACCOMPANIED BY A LAYOUT SHOWN ON A PLAT, INCLUDING SYSTEM REQUIREMENTS.
Granville	087401376512	RESIDENCE ☒	NUMBER OF BEDROOMS:	NUMBER OF OCCUPANTS:	
OWNER: Chris Morrissey	SR. NO.	BUSINESS ☐	3	6 max	
APPLICANT'S ADDRESS:		OTHER ☐	WELL ☒	OTHER ☐	
Same		WATER SUPPLY	PUBLIC ☐	REPAIR ☒	*THIS IMPROVEMENT PERMIT IS SUBJECT TO REVOCATION IF THE INTENDED USES CHANGE FROM THOSE SHOWN ON THE IMPROVEMENT PERMIT. CHANGES SHALL REQUIRE HEALTH DEPARTMENT APPROVAL.
PROPERTY ADDRESS/LOCATION:		TYPE OF WASTEWATER SYSTEM	INITIAL INSTALLATION		
1141 Fleming Rd		DESIGN FLOW:			
SUBDIVISION:		LTAR:			
LOT NUMBER:		ABSORPTION AREA:	Pipe connections must be visually inspected		PERMIT VALID FOR: 5 YEARS YES ☒ NO ☐
REFERENCE SKETCH (SEE PLAT FOR DETAILS)		TRENCH WIDTH:			
Replace Schedule 40 PVC supply line with Schedule 80 PVC supply (2") in area where vehicular traffic will occur		TRENCH DEPTH:			
		TRENCH SPACING:	Septic effluent		
		TOTAL TRENCH LENGTH:	Pump must be run and minimum		
		NUMBER OF TRENCHES:	of 2 foot head		
		GRAVEL DEPTH:	pressure maintained at pressure manifold		
		TANK SIZE:			NO EXPIRATION YES ☐ NO ☒
		PUMP TANK SIZE:			
		DISTRIBUTION DEVICE:			

IMPROVEMENT PERMIT

DATE:

5-6-14

FOR:

ISSUED BY:

Chris Morrissey**David Combee**

CONSTRUCTION AUTHORIZATION FOR IMPROVEMENT PERMIT# **7775**

Unless otherwise indicated, the same conditions above apply regarding system type, layout, location and installation requirements.

(The wastewater system cannot be installed until authorization is signed)

Comments:

Call 919-693-2688 at least 24 hours ahead of inspection

Date:

5-6-14

Environmental Health Specialist:

David CombeeConstruction Authorization Addendum ☐ Yes ☒ No

OPERATION PERMIT

DATE:

5-23-14

SYSTEM INSTALLED BY:

ISSUED BY:

(Owner) Chris Morrissey
David Combee

PERFORMANCE, MONITORING, MAINTENANCE AND OPERATION


AS REQUIRED BY RULE .1961

Granville-Vance District Health Department
Environmental HealthPin 057401378512Permit Number 77725☒ Improvement Permit☒ Construction Authorization

Site Sketch

Chris Morrissey
Applicants Name1141 Fleming Rd
Subdivision - Section 201David Cullen
Authorized State Agent5-6-14 / Inspected
Date 5-23-14

System components represent approximate contours only. The contractor must flag the system prior to beginning the installation to insure that proper grade is maintained.

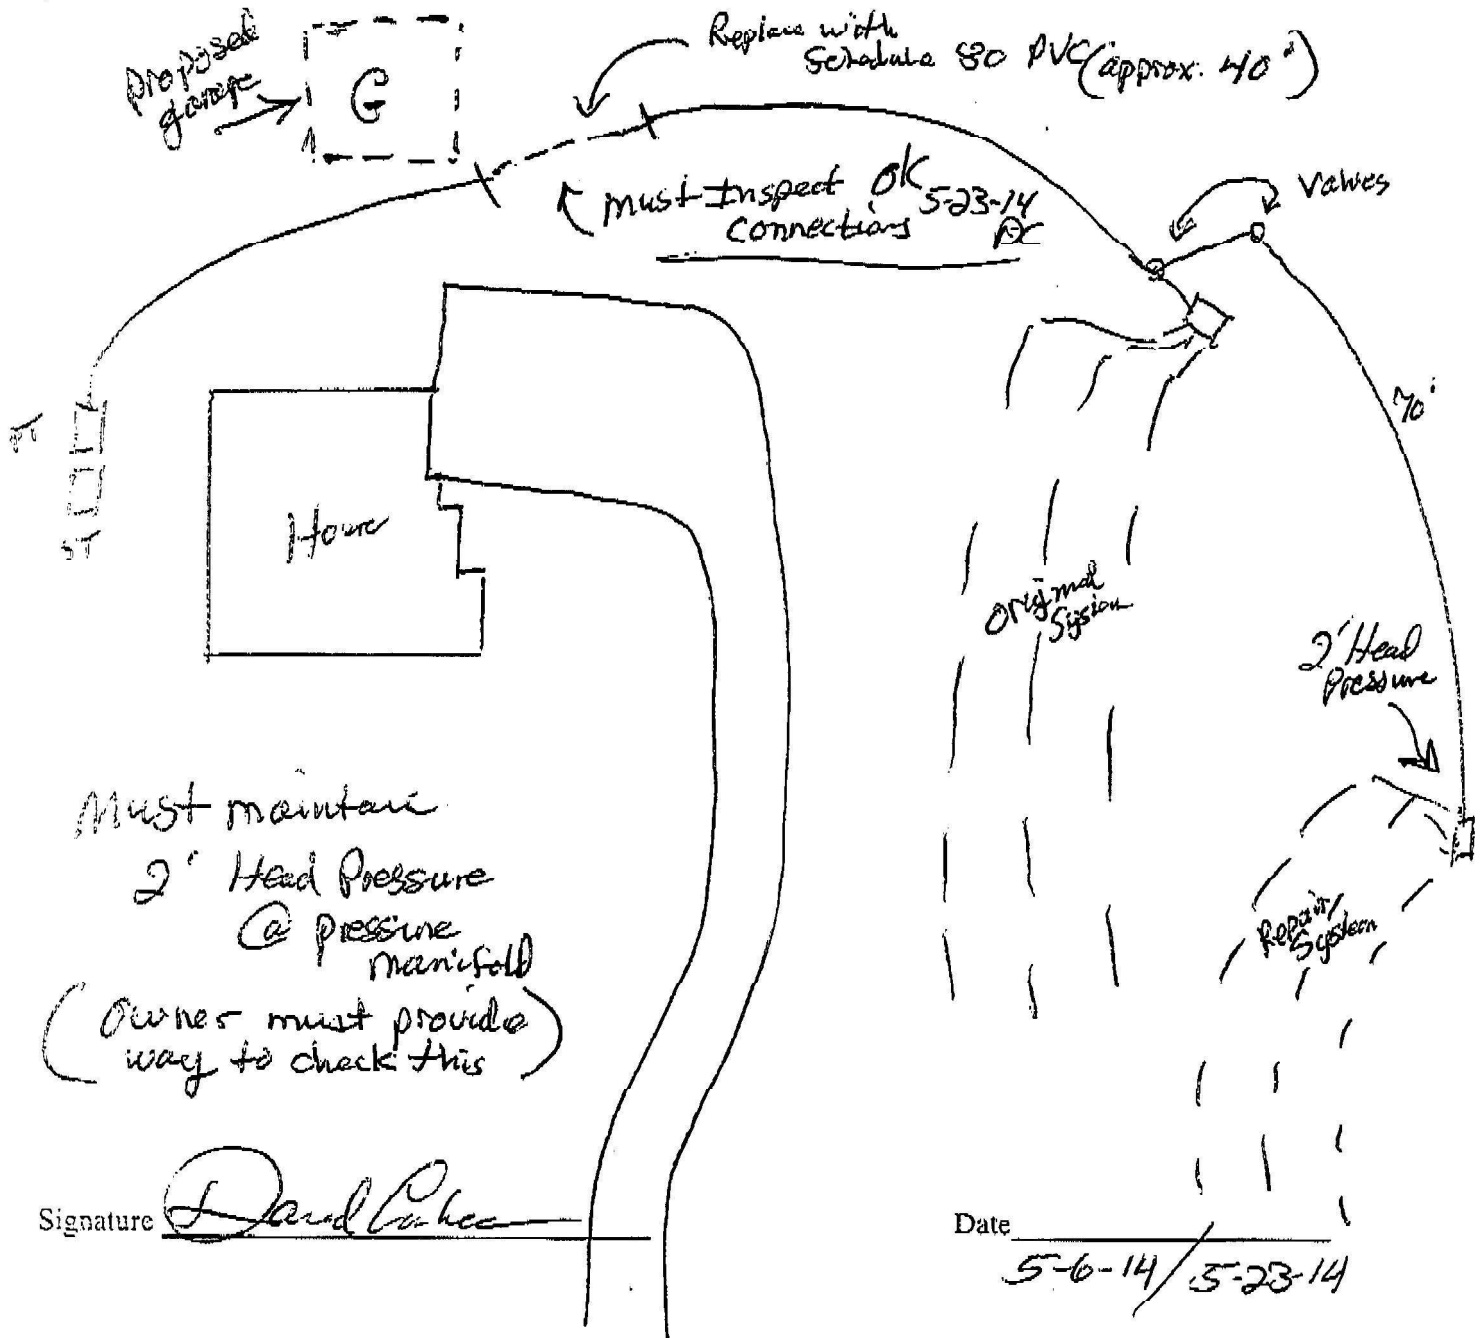



Granville-Vance District Health Department

Lisa M. Harrison, MPH, Health Director
Post Office Box 367
Oxford, North Carolina 27565



Granville County Health Dept.
101 Hunt Drive
Oxford, NC 27565
Phone: (919) 693-2688
Fax: 919-690-0106

Vance County Health Dept.
115 Charles Rollins Road
Henderson, NC 27536
Phone: (252) 492-7915
Fax: (252) 492-4219

Recertification of an Existing On-Site System and Well

Owner Name / Applicant Name: Christopher Morrissey Date: 5-6-14
Physical Address: 1141 Fleming Rd Contact Number: 777-7777
Subdivision: _____ Lot # _____ Zoning Permit # _____

Septic Permit #: 1926 + 3971

Date Installed: 3-6-2000 / 5-5-05

Recertification Of:

Existing House Replacement: Size: _____

Pool: _____ - Size: _____
Septic Redesign/Upgrade: _____
Permit # _____

Addition to House: _____ - Size: _____
Bedroom Addition _____ Septic Upgrade: _____
Permit # _____ New Well: _____

Outbuilding Addition: ☒ - Size: 24'x30'
Garage/Shed

Other Additions to Property: _____

____ All setbacks have been met accordingly at this time.

☒ Onsite Wastewater System is functioning properly at this time.

☒ Onsite Wastewater System is functioning properly at this time, but system upgrade is required.

Permit #: 7775

*** System Upgrade must be completed prior to Certification of Occupancy.

____ Onsite Wastewater System is NOT functioning properly at this time.

Repair Permit #: _____

*** System repair must be completed prior to Certification of Occupancy.

____ Recertification denied, due to: _____

____ Cannot determine due to: _____

Special Instructions: Owner will stay +5' away from septic supply line
(2" PVC) with building & foundation.

David Cohen 5-6-14