

GRANVILLE-VANCE HEALTH DEPARTMENT—Sewage Disposal Record

Owner or Contractor John McDaniel Date 1-11-99 S.R. No. 1734
 Location/Address Jonah Davis Rd.
 Subdivision/Mobile Home Park Name North bend Lot Size 1.512 ± acres
 Permit No. # 1698 Lot No. 15

New System ☒ Repair _____
 House ☒ Mobile Home _____ Business _____
 No. Bedrooms 3 No. People 3 No. Toilets _____
 Water Supply: Private ☒ Approved _____
 Semi-Public _____ Unapproved _____
 Public _____ None _____

Nitrification System:

Tank Size 1000 gal.
 Distribution Box ye No. Lines 2
 Nitrification Field 1050 Sq. Ft.
 Lines:

1	2	3	4	5	6
3'	3'				
132'	132'				
1"	1"				
EEZZ	EEZZ	222	lay		

 Width _____
 Length _____
 Grade _____
 Stone Depth _____


Layout to be followed by installer:

Sketch of layout on back

Improvements Permit By Chris Hedrick Installer Youngs Construction
 Certificate of Completion By David Cumber Date of Inspection 6-18-99

* Construction must comply with all other applicable state and local regulations, but the permit is not a guarantee that the system will not malfunction and the Granville-Vance Health District will not be held responsible for a malfunctioning system.

NOTE: Make sketch of installation showing location of house, septic tanks, privies, water supplies on adjacent property, etc. Write in measurements in order that installations may be located at later date.

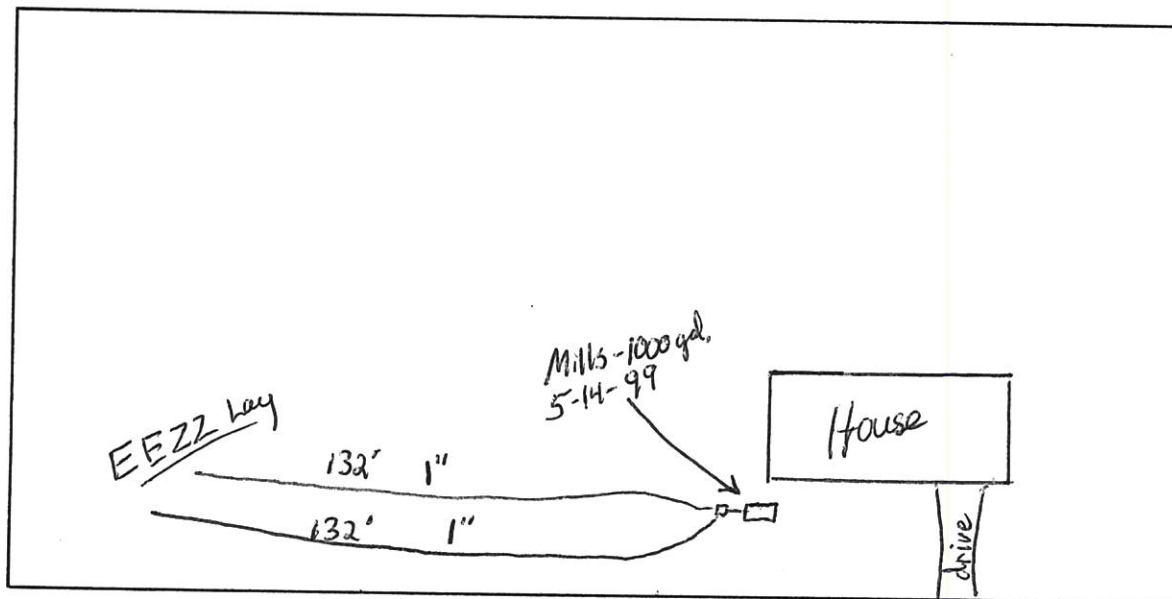

Jonah Davis Rd