


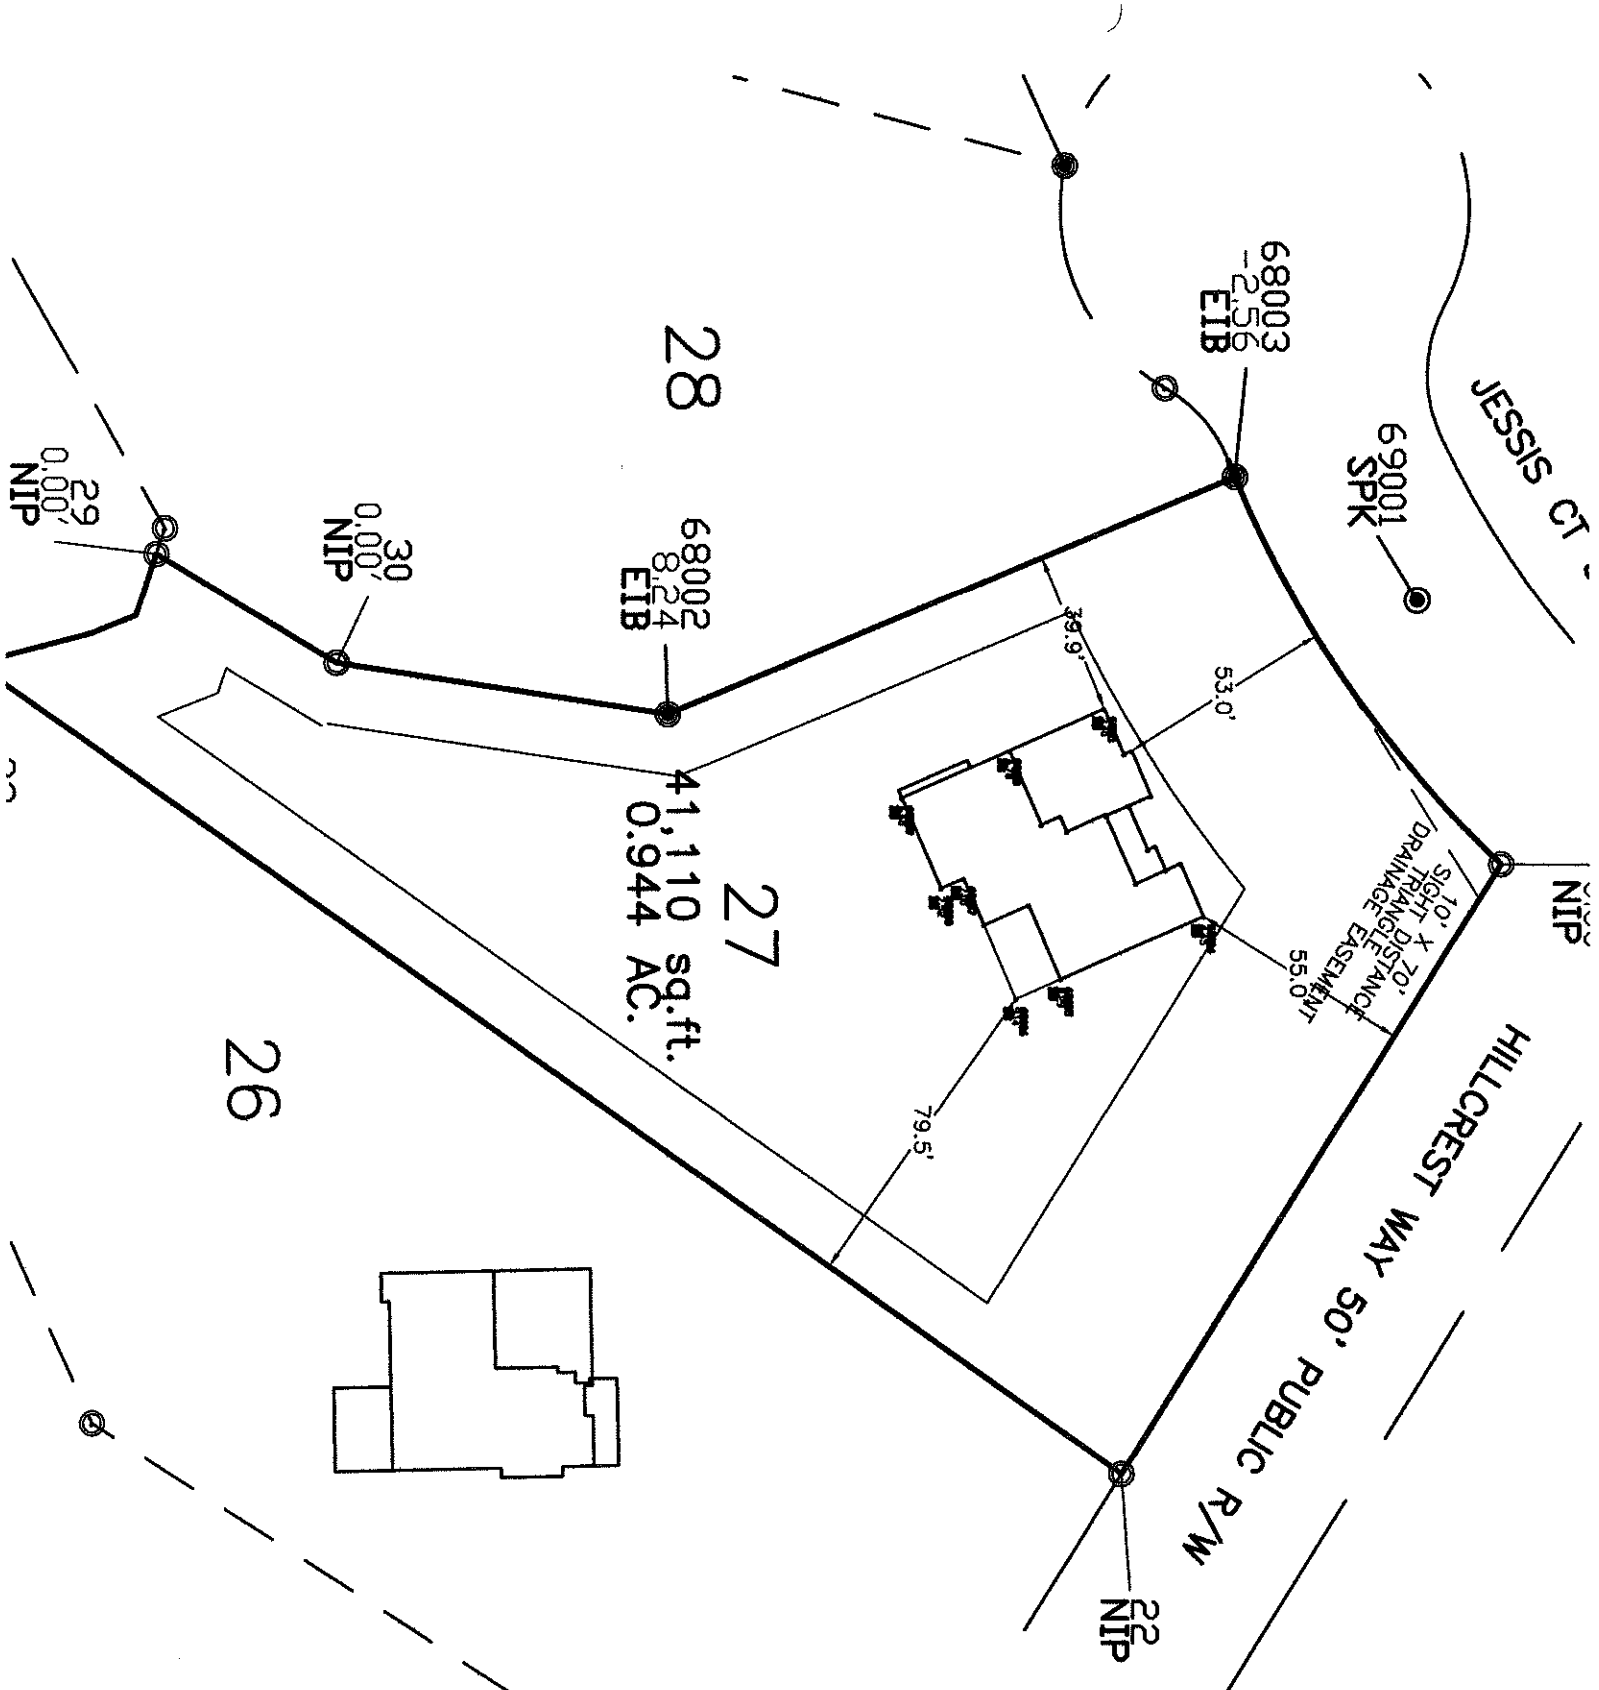

Granville-Vance Dist. Health Department
Environmental Health

Pin 1846000 9934

Permit Number 1132

☒ Improvement Permit

☒ Construction Authorization

SITE SKETCH

Trisha Belle
Applicants Name

Cottle Dr
Address


Wardens Blk 27
Subdivision - Section - Lot

[Signature]
Authorized State Agent

5/12/18
Date

System components represent approximate contours only. The contractor must flag the system prior to beginning the installation to ensure that proper grade is maintained.

*Kitchen sink
min. 10'
off property
line(s)

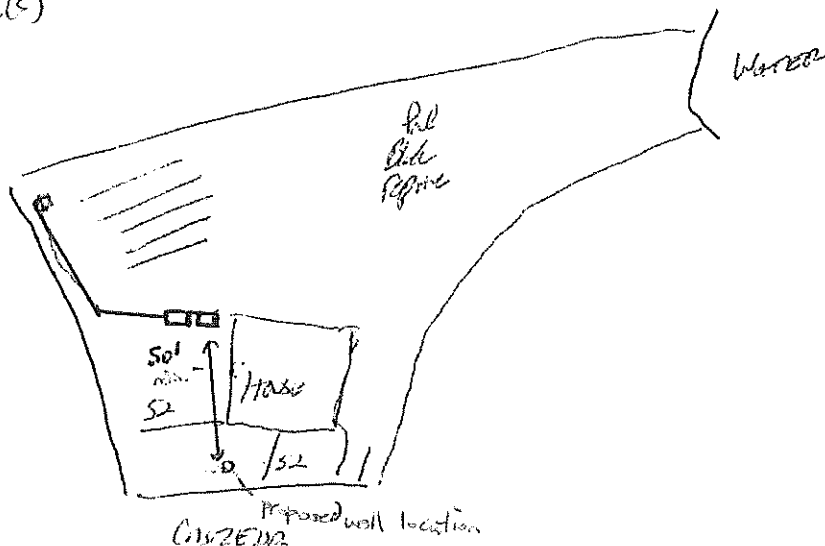

GRANVILLE-VANCE DISTRICT HEALTH DEPARTMENT IMPROVEMENT AND OPERATION PERMITS

COUNTY:	TAX NO. 1846000 99 361	TYPE OF ESTABLISHMENTS			*THIS PERMIT SHALL BE ACCOMPANIED BY A LAYOUT SHOWN ON A PLAT, INCLUDING SYSTEM REQUIREMENTS.
APPLICANT'S NAME & ADDRESS Granville Traditions Builder 28449 Cr Franklin, N.C. 27525	LOT SIZE	RESIDENCE ☒ BUSINESS ☐ OTHER ☐	NUMBER OF BEDROOMS: 4	NUMBER OF OCCUPANTS: 8 approx.	
		WATER SUPPLY WELL ☒ PUBLIC ☐	INITIAL INSTALLATION	REPAIR	
		TYPE OF WASTEWATER SYSTEM	456	100% Approved	
PROPERTY ADDRESS/LOCATION:		DESIGN FLOW:	480 GPD		*THIS IMPROVEMENT PERMIT IS SUBJECT TO REVOCATION IF THE INTENDED USE CHANGES FROM THOSE SHOWN ON THE IMPROVEMENT PERMIT. CHANGES SHALL REQUIRE HEALTH DEPARTMENT APPROVAL.
Castle Dr.		LTAR:	3600 / hr		
SUBDIVISION:		ABSORPTION AREA:	1600 / hr		
Winnow Valley		TRENCH WIDTH	3'		
LOT NUMBER: 27		TRENCH DEPTH:	24-28"	14-16"	
REFERENCE SKETCH (SEE PLAT FOR DETAILS)		TRENCH SPACING:	9' O.C.	20' C.C.	
- No foundation drain		TOTAL TRENCH LENGTH:	400'	200'	
- Follow centerline		NUMBER OF TRENCHES:	4 or 5	3	
- DEM 400 control panel w/ alarm		GRAVEL / ACCEPTED:			
1/2"-3/4" pipe w/ adjustment valves		TANK SIZE:	1000		
- Contact H&P prior to installation		PUMP TANK SIZE:	1000		
		DISTRIBUTION DEVICE:	Pressure manifold	LPP	PERMIT VALID FOR: 5 YEARS YES NO
					NO EXPIRATION YES NO

IMPROVEMENT PERMIT

DATE: 8/15/18

 FOR: Traditions Builder
 ISSUED BY: [Signature]

CONSTRUCTION AUTHORIZATION FOR IMPROVEMENT PERMIT# 1133

Unless otherwise indicated, the same conditions above apply regarding system type, layout, location and installation requirement.

(The wastewater system cannot be installed until authorization is signed)

Comments:

 Date: 8/15/18 Environmental Health Specialist: [Signature]
 Construction Authorization Addendum ☒ Yes ☐ No

OPERATION PERMIT

DATE:

 SYSTEM INSTALLED BY: _____
 ISSUED BY: _____

PERFORMANCE, MONITORING, MAINTENANCE AND OPERATION

AS REQUIRED BY R.H.F. 1961

Granville-Vance Dist. Health Department
Environmental Health

Pin 186000 9934

Permit Number 1132

☒ Improvement Permit

☒ Construction Authorization

SITE SKETCH

Travis Belle
Applicants Name


Coke St
Address

Wade Lake 27
Subdivision - Section - Lot

[Signature]
Authorized State Agent

5/15/18
Date

System components represent approximate contours only. The contractor must flag the system prior to beginning the installation to ensure that proper grade is maintained.

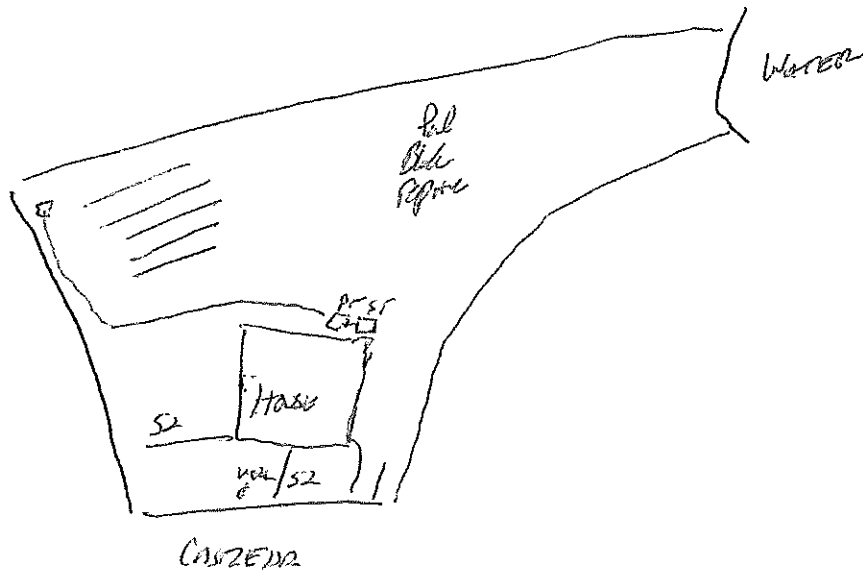

Granville - Vance District Health Department

Environmental Health

Well Construction Permit

2574

Owner/Applicant: T. Smith, B. Smith

Date: 8/15/18

Address or Location of Property: Smith Dr

Subdivision & Lot #: W. Smith Ldr

Septic Permit #: 1133

Zoning Permit #: _____

Environmental Health Specialist: CWC

This well permit is to locate and site the area that a private groundwater well may be established on the property listed above by the Environmental Health Specialists of Granville County. If one does not locate the well in the approved area and complete the well as specified by the 15A NCAC .02C rules, then permits may be revoked. At completion of drilling of the well, grout must be witnessed by EHS and a well log turned into Environmental Health.

Minimum Setbacks: (these are the main setbacks, but not all required setbacks)

Setback from property lines – 10 ft

Setback from septic tank and drain field, including repair area – 100 ft

Setback from structural foundations – 25 ft

Setback from ponds, lakes or other bodies of water – 50 ft

Site Sketch:

Conditions: _____

Authorized Agent: CWC

Date: 8/15/18

1 Well Grout: (Circle or write in)

Witnessed: Yes or No EHS Agent: _____

Date: _____ Annular Space Open: Yes or No

Over reamed: Yes or No Depth Grouted: _____

Method: _____ Pump _____ Poured _____ Pressure

Well Log received: Yes or No (EHS to Attach to Permit)

Driller Name: _____ Cert. # _____

Depth: _____ Casing Depth: _____ GPM: _____

2 Well Final: (Place a check mark when finalized)

Seal Present and Intact: _____ Air Vent: _____

Hose Spigot: _____ Electrical Box: _____

Pump Installer Tag: _____ Well Installer Tag: _____

All holes sealed: _____ 12" above grade: _____

Comments: _____

3 Well Completion Permit: _____ EHS

Date Completed: _____

4 Water Samples Taken: Date: _____

EHS: _____ Results: _____

Retest: _____ Results: _____

As Built Drawing:

Granville-Vance Dist. Health Department
Environmental Health

Pin 1846000 99 34

Permit Number 1122

☒ Improvement Permit

☒ Construction Authorization

SITE SKETCH

Trish Bull
Applicants Name

Coke Dr
Address

Warren Hills 27
Subdivision - Section - Lot

[Signature]
Authorized State Agent

5/12/18
Date

System components represent approximate contours only. The contractor must flag the system prior to beginning the installation to ensure that proper grade is maintained.

