

Granville - Vance District Health Department

Environmental Health

Well Construction Permit

Owner/Applicant: John Foster Homes Date: 8-11-08
Address or Location of Property: 135 Cherokee Way South 2470A01004


Subdivision & Lot #: Cherokee East 237 Septic Permit #: 00000
Zoning Permit #: _____ Environmental Health Specialist: SMITH

This well permit is to locate and site the area that a private groundwater well may be established on the property listed above by the Environmental Health Specialists of Granville County. If one does not locate the well in the approved area and complete the well as specified by the 15A NCAC .02C rules, then permits may be revoked. At completion of drilling of the well, grout must be witnessed by EHS and a well log turned into Environmental Health.

Minimum Setbacks: (these are the main setbacks, but not all required setbacks)

Setback from property lines – 10 ft Setback from septic tank and drain field, including repair area – 100 ft
Setback from structural foundations – 25 ft Setback from ponds, lakes or other bodies of water – 50 ft

Site Sketch:

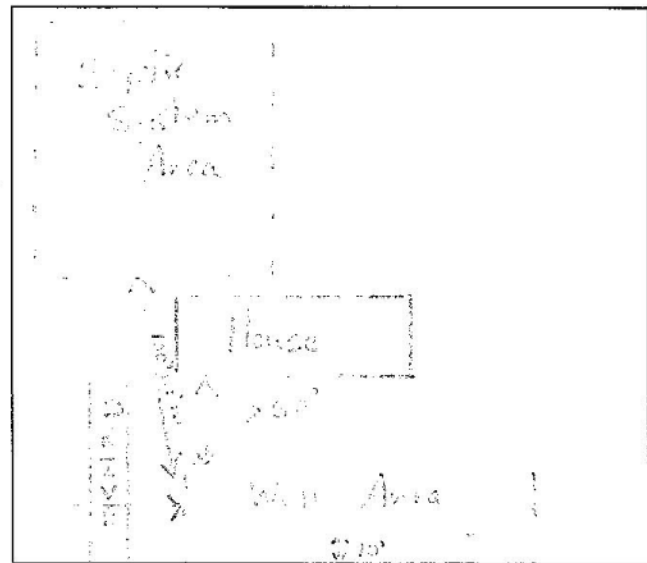

Conditions: Hensley 64' casing
30' static

Authorized Agent: Mac Shingleton, R2
Date: 8-12-08

Well Grout: (Circle or write in)

Witnessed: Yes or No EHS Agent: Mac Shingleton, R2

Date: 8-21-08 Annular Space Open: Yes or No


Over reamed: Yes or No

Method: Pump ☒ Poured ☐ Pressure ☐

Depth Grouted: 20 ft

Well Log received: Yes or No (EHS to Attach to Permit)

As Built Drawing:

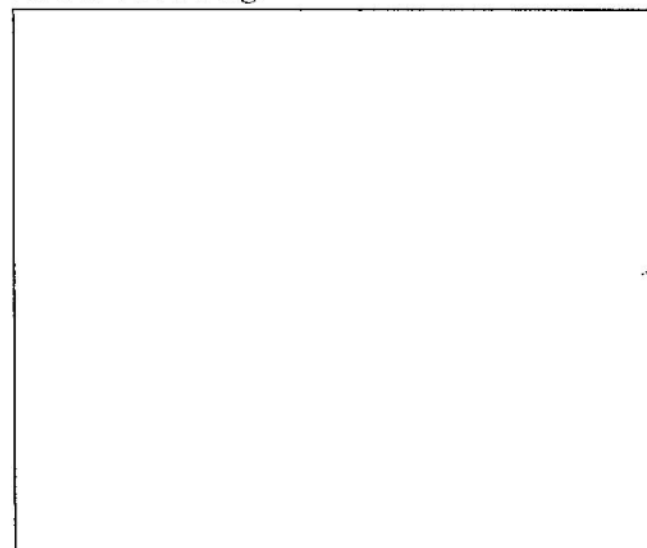

Well Final: (Place a check mark when finalized)

Seal Present and Intact: ☒ Air Vent: ☒

Hose Spigot: ☒ Electrical Box: ☒

Pump Installer Tag: ☒ Well Installer Tag: ☒

All holes sealed: ☒ 12" above grade: ☒

Comments: _____

Well Completion Permit: Mac Shingleton, EHS

Date Completed: 8-28-08

Water Samples Taken: Date: _____

EHS: _____ Results: _____

Retest: _____ Results: _____