

NO 1369

GRANVILLE-VANCE DISTRICT HEALTH DEPARTMENT
IMPROVEMENT PERMIT AND CERTIFICATE OF COMPLETION


OWNER/AGENT Dorothy Keeney
LOCATION 501. Pt. Rd. 133 Bowman Ln STATE ROAD NO. _____
SUBDIVISION NAME Tanner Farm 0595301021 LOT NO. 17

SYSTEM DESIGNED FOR:

NEW SYSTEM ☒ REPAIR _____ RESIDENCE UTI BUSINESS _____ OTHER _____
NO. BEDROOMS 3 NO. OCCUPANTS _____ WATER SUPPLY: INDIVIDUAL ☒ PUBLIC _____
LOT SIZE 1.4 ACRES F _____ L _____ B _____ R _____
SEPTIC TANK 1000 GALLONS PUMP TANK _____ GALLONS DISTRIBUTION box
NITRIFICATION FIELD 900 SQUARE FEET NUMBER OF LINES 1
LENGTH OF LINES 300 WIDTH OF LINES 36" STONE DEPTH 18"

CONDITIONS _____

LAYOUT

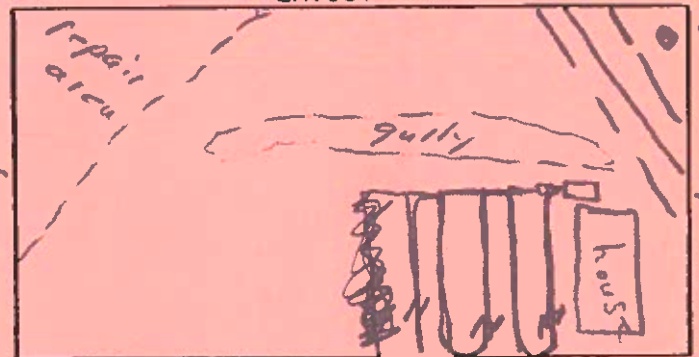

NOTICE: The above are minimum specifications for a sewage disposal system on the above captioned property. This permit is subject to compliance with local zoning and building regulations and all the provisions of the Laws and Rules for Sanitary Sewage Collection, Treatment, and Disposal of the North Carolina Administrative Code. This permit may not be altered without written permission from a representative of the Granville-Vance District Health Department. System must be installed within _____ years of date of issuance. This permit is subject to revocation if site plans or the intended use changes.

I understand the requirements of this permit and the information I have provided is accurate to the best of my knowledge.

OWNER/AGENT _____ DATE _____
IMPROVEMENT PERMIT BY: Walter T. Vaughn RS DATE 12-9-95
CERTIFICATE OF COMPLETION BY: Walter T. Vaughn RS DATE 10-2-95
SYSTEM INSTALLED BY: Jerry Bolton

NOTICE: This approval indicates that the installation complies with all applicable state and local regulations, but shall in no way be taken as a guarantee that the system will function satisfactorily for any given period of time and the Granville-Vance District Health Department will not be held responsible for a malfunctioning system.