

GRANVILLE-VANCE HEALTH DEPARTMENT—Sewage Disposal Record

Owner or Contractor Tammy Elli Date 1-31-02 S.R. No. NC 965
Location/Address 2253 NC 965, Franklinton, NC 27525
Subdivision/Mobile Home Park Name _____ Lot Size _____
Permit No. # 3248 _____ Lot No. _____

New System _____ Repair ☒ _____
House ☒ Mobile Home _____ Business _____
No. Bedrooms 3 No. People _____ No. Toilets _____
Water Supply: Private ☒ Approved _____
Semi-Public _____ Unapproved _____
Public _____ None _____

Nitrification System:

Tank Size existing gal. 3

Distribution Box ✓ No. Lines ✓

Nitrification Field 700 Sq. Ft.

Lines: 1 2 3 4 5 6

Width 3' 3' 3'

Length $50' / 30' \quad 32' / 32' / 31' \quad 45' / 50'$

Grade $\frac{0^{\circ}}{0^{\circ}}$ $\frac{0^{\circ}}{0^{\circ}}$ $\frac{0^{\circ}}{0^{\circ}}$ $\frac{0^{\circ}}{0^{\circ}}$


Stone Depth $12^1/12^2$ $12^1/12^2/12^3$ $12^1/12^2$

Layout to be followed by installer:

Improvements Permit By Eddie Yount Installer Leonard O'Bryant
Certificate of Completion By Eddie Yount Date of Inspection 1-31-02

* Construction must comply with all other applicable state and local regulations, but the permit is not a guarantee that the system will not malfunction and the Granville-Vance Health District will not be held responsible for a malfunctioning system.

NOTE: Make sketch of installation showing location of house, septic tanks, privies, water supplies on adjacent property, etc. Write in measurements in order that installations may be located at later date.

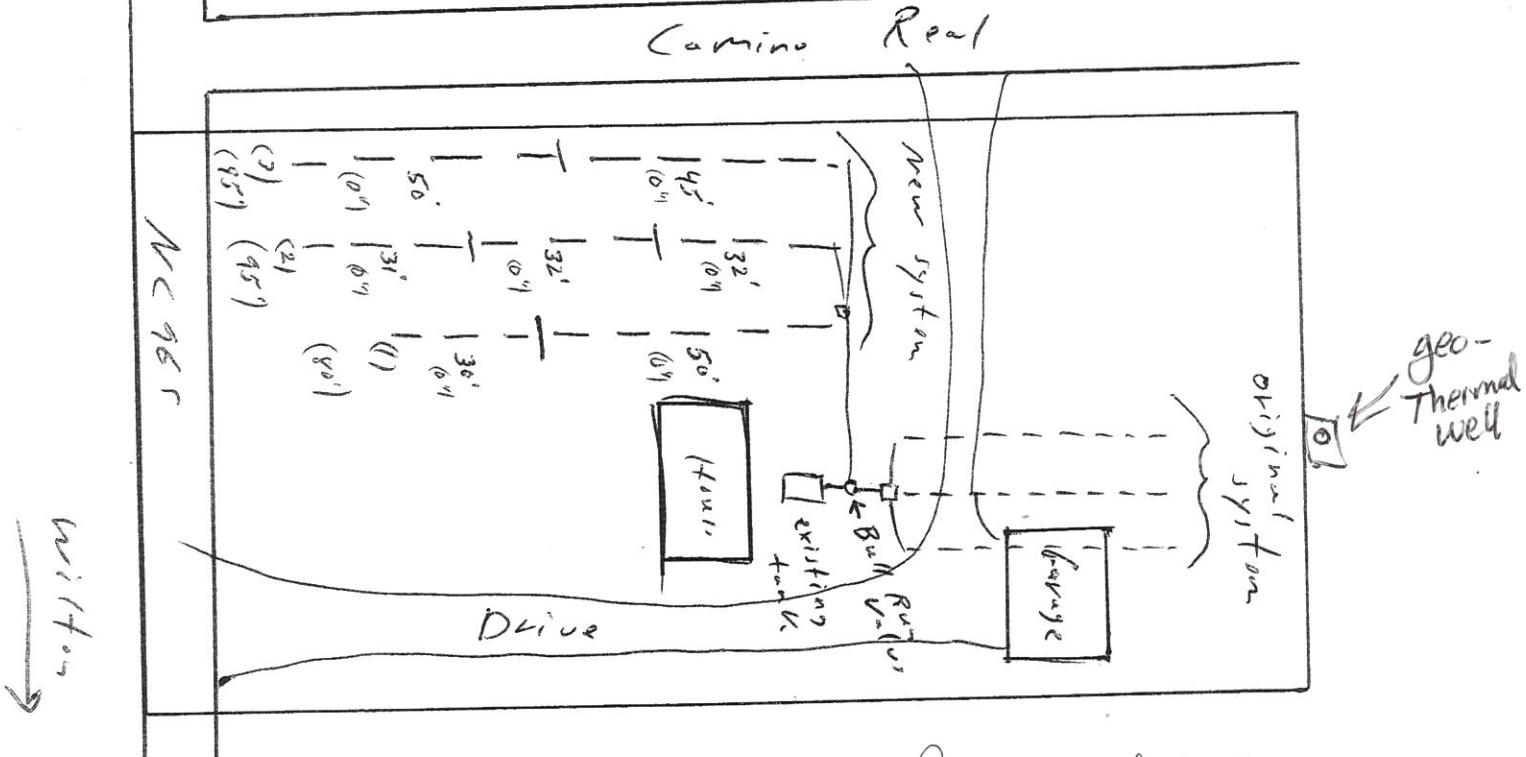

Repair drainfield
1-31-02