


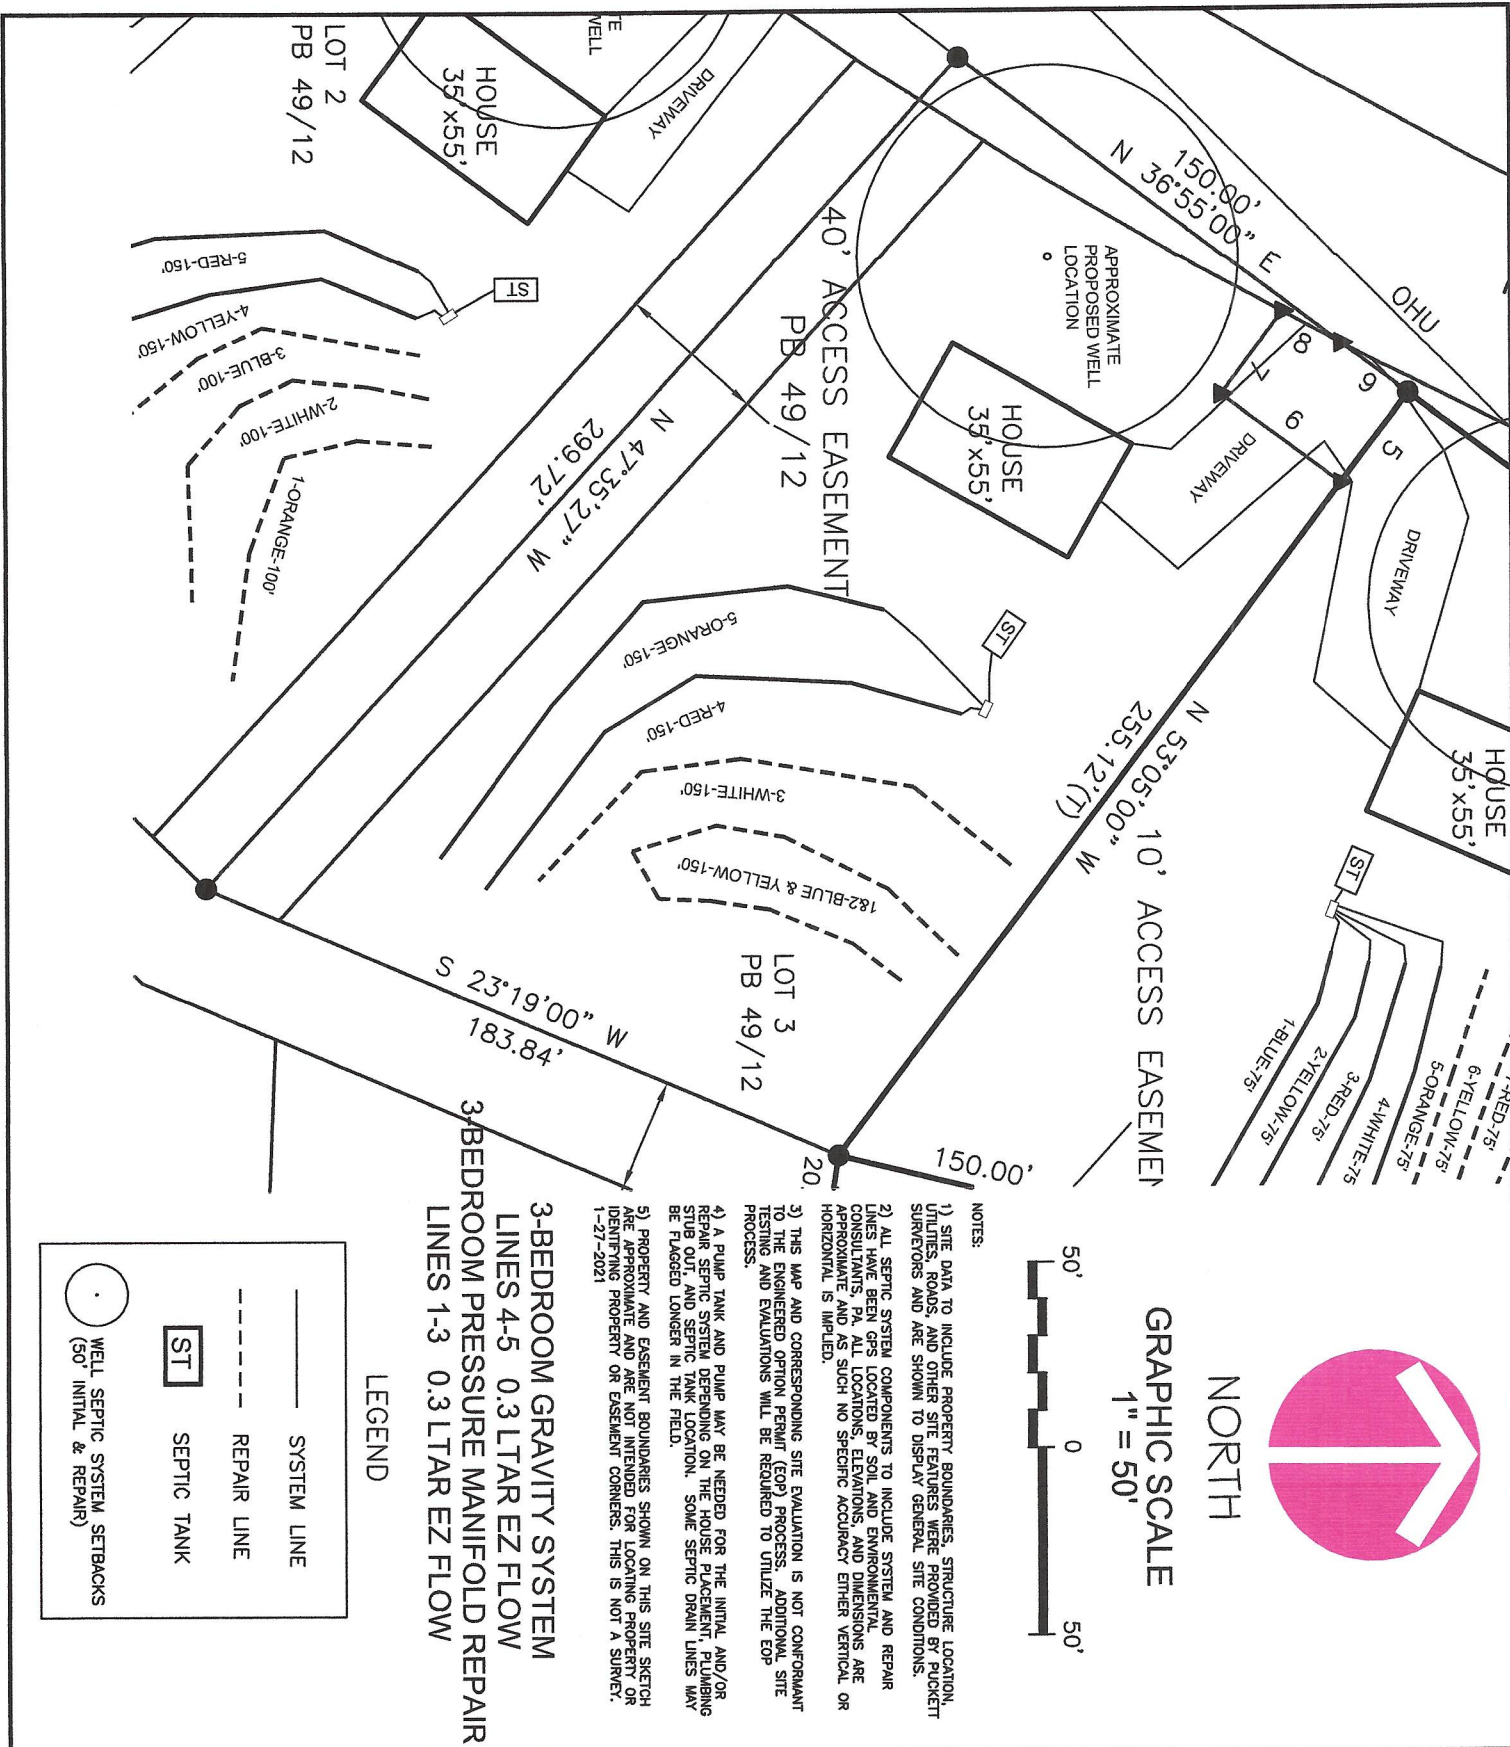

S&EC

Soil & Environmental Consultants, PA

8412 Falls of Neuse Rd., Suite 104 • Raleigh, North Carolina 27615 • www.SandEC.com
Phone: (919) 846-5900 • Fax: (919) 846-9467

Project: HANCOCK ROAD LOT 3		Project No.: 14573.51	
Location: GRANVILLE CO., NC		Project Manager: CC	Drawn: CC
Client: PINNACLE HOME BUILDERS		Scale: 1" = 50'	Field Work: CC, JM
Sheet Title: SEPTIC LAYOUT MAP		Sheet No.: 1 of 1	