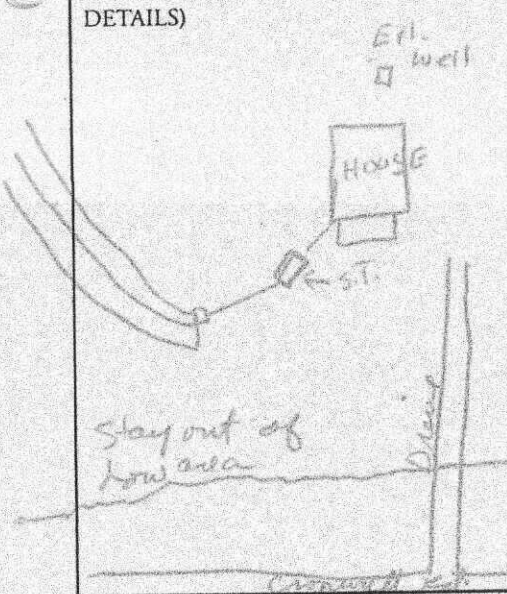


need Waiver

Norman Clifford 2:00 P.M.
Tuesday Sept 16th 11:30 2003
PERMIT NUMBER 3547

Hold for Waiver

GRANVILLE-VANCE DISTRICT HEALTH DEPARTMENT IMPROVEMENT AND OPERATION PERMITS

COUNTY:	TAX NO. 190800101547	TYPE OF ESTABLISHMENT			*THIS PERMIT SHALL BE ACCOMPANIED BY A LAYOUT SHOWN ON A PLAT, INCLUDING SYSTEM REQUIREMENTS. *THE IMPROVEMENTS PERMIT MUST BE ATTACHED TO A CONSTRUCTION AUTHORIZATION BEFORE OBTAINING BUILDING PERMIT OR OTHER CONSTRUCTION PERMITS AND BEFORE A WASTEWATER SYSTEM IS INSTALLED.
Granville	SR. NO. 1300	RESIDENCE ☒ BUSINESS ☐ OTHER ☐	NUMBER OF BEDROOMS: 2	NUMBER OF OCCUPANTS: 1	
OWNER: Amy + James Malugen					
APPLICANT:		WATER SUPPLY			
APPLICANT'S ADDRESS: 7669 Cornwall 1st cty		PUBLIC ☐	WELL ☒	OTHER ☐	
PROPERTY ADDRESS/LOCATION: on left before Little Mt. creek R		TYPE OF WASTEWATER SYSTEM			*THIS IMPROVEMENT PERMIT IS SUBJECT TO RELOCATION IF THE INTENDED USES CHANGE FROM THOSE SHOWN ON THE IMPROVEMENT PERMIT. CHANGES SHALL REQUIRE HEALTH DEPARTMENT APPROVAL.
Existing House		DESCRIPTION	INITIAL INSTALLATION	REPAIR	
SUBDIVISION: 10992	DESIGN FLOW:	240			
LOT NUMBER: Farm	LTAR:	1265			
REFERENCE SKETCH (SEE PLAT FOR DETAILS) 	ABSORPTION AREA:	900			
	TRENCH WIDTH:	3			
	TRENCH SPACING:	9			
	TOTAL TRENCH LENGTH:	300	225 ft		
	NUMBER OF TRENCHES:	3			
	GRAVEL DEPTH:	12	36 units 37 ft infiltration		
	TANK SIZE:	1000			
CONDITIONS:		See Authorization Form			
IMPROVEMENT PERMIT				DATE:	
FOR: Amy + James Malugen				8-21-02	
ISSUED BY: Jimmy B. Clayton, P.S.					
OPERATION PERMIT				DATE:	
SYSTEM INSTALLED BY:					
ISSUED BY:					

Granville - Vance District Health Department

Environmental Health

Well Construction Permit

2065

Owner/Applicant: Amy Malugen

Date: 4-27-17

Address or Location of Property: 7689 Cornwall Rd

Subdivision & Lot #: _____

Septic Permit #: _____

Zoning Permit #: _____

Environmental Health Specialist: AWC

This well permit is to locate and site the area that a private groundwater well may be established on the property listed above by the Environmental Health Specialists of Granville County. If one does not locate the well in the approved area and complete the well as specified by the 15A NCAC .02C rules, then permits may be revoked. At completion of drilling of the well, grout must be witnessed by EHS and a well log turned into Environmental Health.

Minimum Setbacks: (these are the main setbacks, but not all required setbacks)


Setback from property lines – 10 ft

Setback from septic tank and drain field, including repair area – 100 ft

Setback from structural foundations – 25 ft

Setback from ponds, lakes or other bodies of water – 50 ft

Site Sketch:

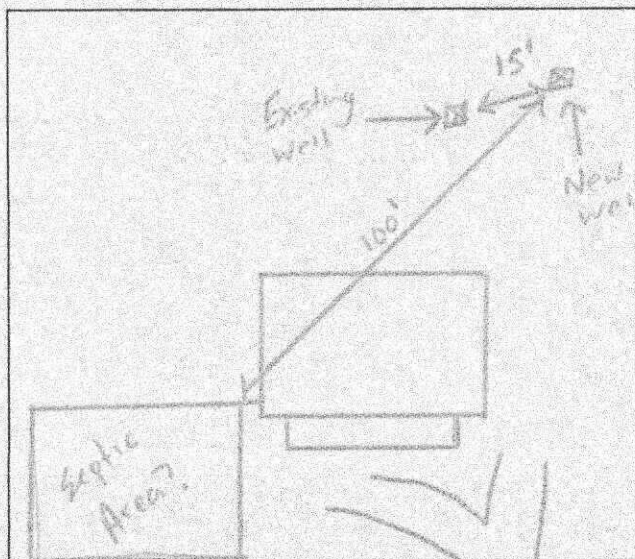

Conditions: Septic tank and lines must be flagged before drilling or permit is void.

Authorized Agent: [Signature]

Date: 4-27-17

1 Well Grout: (Circle or write in)

Witnessed: Yes or No EHS Agent: _____

Date: _____ Annular Space Open: Yes or No

Over reamed: Yes or No Depth Grouted: _____

Method: _____ Pump _____ Poured _____ Pressure

Well Log received: Yes or No (EHS to Attach to Permit)

Driller Name: _____ Cert. # _____

Depth: _____ Casing Depth: _____ GPM: _____

2 Well Final: (Place a check mark when finalized)

Seal Present and Intact: _____ Air Vent: _____

Hose Spigot: _____ Electrical Box: _____

Pump Installer Tag: _____ Well Installer Tag: _____

All holes sealed: _____ 12" above grade: _____

Comments: _____

3 Well Completion Permit: _____ **EHS**

Date Completed: _____

4 Water Samples Taken: Date: _____

EHS: _____ **Results:** _____

Retest: _____ **Results:** _____

As Built Drawing:

