

Granville - Vance District Health Department

Environmental Health

Well Construction Permit

Owner/Applicant: Wynn Construction Date: 2-15-2010
Address or Location of Property: 2704 Longstret Ct


Subdivision & Lot #: Rennshaw 19 Septic Permit #: 6500
Zoning Permit #: 16585 Environmental Health Specialist: David Rumble

This well permit is to locate and site the area that a private groundwater well may be established on the property listed above by the Environmental Health Specialists of Granville County. If one does not locate the well in the approved area and complete the well as specified by the 15A NCAC .02C rules, then permits may be revoked. At completion of drilling of the well, grout must be witnessed by EHS and a well log turned into Environmental Health.

Minimum Setbacks: (these are the main setbacks, but not all required setbacks)

Setback from property lines - 10 ft Setback from septic tank and drain field, including repair area - 100 ft
Setback from structural foundations - 25 ft Setback from ponds, lakes or other bodies of water - 50 ft

Site Sketch:

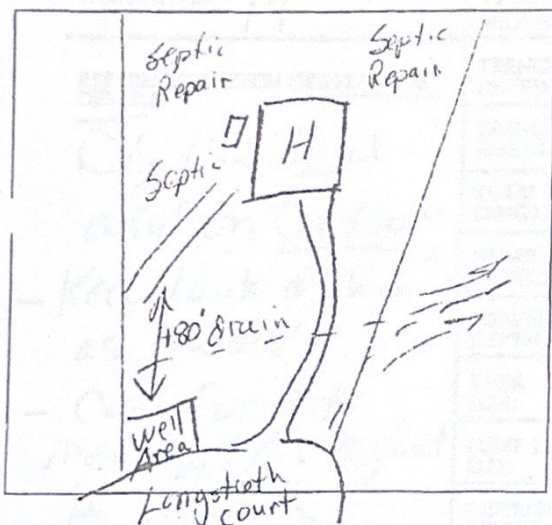


Conditions: Call 693-2688 w/questions

Authorized Agent: David Rumble
Date: 2-15-2010

Well Grout: (Circle or write in)
Witnessed: Yes or No EHS Agent: David Rumble
Date: 5-10-10 Annular Space Open: Yes or No
Over reamed: Yes or No
Method: Pump ✓ Poured Pressure
Depth Grouted: 20' ft
Well Log received: Yes or No (EHS to Attach to Permit)

As Built Drawing:

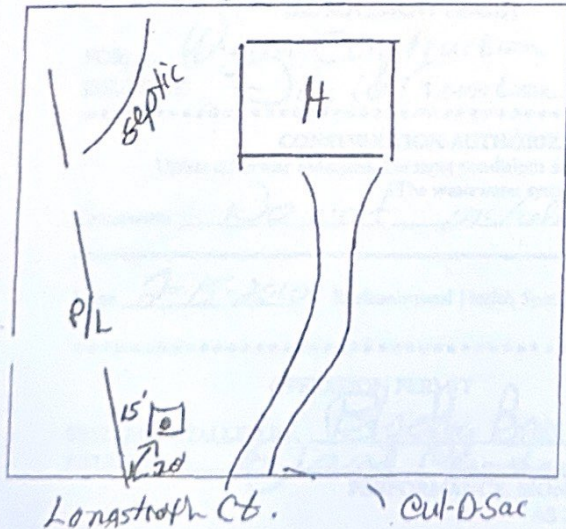

Well Final: (Place a check mark when finalized)

Seal Present and Intact: ✓ Air Vent: ✓
Hose Spigot: ✓ Electrical Box: ✓
Pump Installer Tag: ✓ Well Installer Tag: ✓
All holes sealed: ✓ 12" above grade: ✓

Comments:

200'
1/2 HP

Well Completion Permit: David Rumble EHS
Date Completed: 5-27-10

Water Samples Taken: Date: _____
EHS: _____ Results: _____
Retest: _____ Results: _____

Blockley 3:00-3:30 Pump

PERMIT NUMBER 00600

GRANVILLE-VANCE DISTRICT HEALTH DEPARTMENT
IMPROVEMENT AND OPERATION PERMITS 16585

COUNTY:	TAX NO.	TYPE OF ESTABLISHMENTS			*THIS PERMIT SHALL BE ACCOMPANIED BY A LAYOUT SHOWN ON A PLAT, INCLUDING SYSTEM REQUIREMENTS.
Granville	183700360412	RESIDENCE ☒	NUMBER OF BEDROOMS:	NUMBER OF OCCUPANTS:	
OWNER: Wynn Construction	SR NO. 1629	BUSINESS ☐	3	6 max	
APPLICANT'S ADDRESS:		OTHER ☐	WELL PUBLIC ☐	OTHER ☐	
2550 Capital Dr. Suite 105 Circleville		WATER SUPPLY	INITIAL INSTALLATION	REPAIR (Pump)	*THIS IMPROVEMENT PERMIT IS SUBJECT TO REVOCATION IF THE INTENDED USES CHANGE FROM THOSE SHOWN ON THE IMPROVEMENT PERMIT. CHANGES SHALL REQUIRE HEALTH DEPARTMENT APPROVAL.
PROPERTY ADDRESS/LOCATION:		TYPE OF WASTEWATER SYSTEM	Type III g	Type III g	
2704 Longstreet Ct.		DESIGN FLOW:	360 gpd		
SUBDIVISION: J		LTAR:	279 gal/yr		
Rennshire		ABSORPTION AREA:	1318 ft ²		5-10-10
LOT NUMBER: 19		TRENCH WIDTH:	3'		
REFERENCE SKETCH (SEE PLAT FOR DETAILS)		TRENCH DEPTH:	27"		
Dig lines level and on contour		TRENCH SPACING:	9' o.c.		
- Keep tank as high as possible.		TOTAL TRENCH LENGTH:	330'		PERMIT VALID FOR 5 YEARS YES ☒ NO ☐
- Call for site meeting +/or layout if needed		NUMBER OF TRENCHES:	4 or 5		
693-2658		GRAVEL DEPTH:	Accepted status (non-gravel)		
		TANK SIZE:	1000 gal.		
		PUMP TANK SIZE:	1000 gal.		NO EXPIRATION YES ☐ NO ☒
		DISTRIBUTION DEVICE:	Box Pressure Main		

IMPROVEMENT PERMIT DATE: 2-15-2010
FOR: Wynn Construction
ISSUED BY: David Cumber

CONSTRUCTION AUTHORIZATION FOR IMPROVEMENT PERMIT# 6800
Unless otherwise indicated, the same conditions above apply regarding system type, layout, location and installation requirements.
(The wastewater system cannot be installed until authorization is signed)
Comments: Do not install in wet conditions

Date: 2-15-2010 Environmental Health Specialist: David Cumber
Construction Authorization Addendum ☐ Yes ☒ No

OPERATION PERMIT DATE: 5-10-2010 / 7-12-2010
SYSTEM INSTALLED BY: Blockley Bros.
ISSUED BY: David Cumber
PERFORMANCE, MONITORING, MAINTENANCE AND OPERATION AS REQUIRED BY RULE .1961



RESIDENTIAL WELL CONSTRUCTION RECORD

North Carolina Department of Environment and Natural Resources - Division of Water Quality

WELL CONTRACTOR CERTIFICATION # 3104

1. WELL CONTRACTOR:

Van Elliott

Well Contractor (Individual) Name

SOUTHERN WELL DRILLING

Well Contractor Company Name

STREET ADDRESS 1530 Beaver Dam Road

Creedmoor NC 27522

City or Town State Zip Code

(919) 603-7165

Area code - Phone number

2. WELL INFORMATION:

SITE WELL ID # (if applicable) 00214

STATE WELL PERMIT # (if applicable)

DWQ or OTHER PERMIT # (if applicable)

WELL USE (Check Applicable Box): Residential Water Supply ☐

DATE DRILLED 5-4-10

TIME COMPLETED ☐ AM ☐ PM

3. WELL LOCATION:

CITY: Franklin COUNTY Granville

Rennshire Lot 19
(Street Name, Numbers, Community, Subdivision, Lot No., Parcel, Zip Code)

TOPOGRAPHIC / LAND SETTING:

☒ Slope ☐ Valley ☐ Flat ☐ Ridge ☐ Other
(check appropriate box)

LATITUDE 3

LONGITUDE

May be in degrees,
minutes, seconds or
in a decimal format

Latitude/longitude source: ☐ GPS ☐ Topographic map

(location of well must be shown on a USGS topo map and
attached to this form if not using GPS)

4. WELL OWNER

OWNER'S NAME Wynn Const.

STREET ADDRESS

Creedmoor NC

City or Town

State

Zip Code

Area code - Phone number

5. WELL DETAILS:

a. TOTAL DEPTH: 300

b. DOES WELL REPLACE EXISTING WELL? YES ☐ NO ☒

c. WATER LEVEL Below Top of Casing: 30 FT.
(Use "+" if Above Top of Casing)

d. TOP OF CASING IS 41 FT. Above Land Surface*
*Top of casing terminated at/or below land surface may require
a variance in accordance with 15A NCAC 2C .0118.

e. YIELD (gpm): 20 METHOD OF TEST Air

f. DISINFECTION: Type Amount

g. WATER ZONES (depth):

From 110 To 300 From To

From To From To

From To From To

6. CASING:

Depth Diameter Thickness/Weight Material

From 1 To 100 Ft. 6 PVC

From To Ft.

From To Ft.

7. GROUT:

Depth Material Method

From 0 To 20 Ft. Pourland Poured

From To Ft.

From To Ft.

8. SCREEN:

Depth Diameter Slot Size Material

From To Ft. in. in.

From To Ft. in. in.

From To Ft. in. in.

9. SAND/GRAVEL PACK:

Depth Size Material

From To Ft.

From To Ft.

From To Ft.

10. DRILLING LOG

From To Formation Description

11. REMARKS:

Rennshire Lot 19

I DO HEREBY CERTIFY THAT THIS WELL WAS CONSTRUCTED IN ACCORDANCE WITH
15A NCAC 2C. WELL CONSTRUCTION STANDARDS, AND THAT A COPY OF THIS
RECORD HAS BEEN PROVIDED TO THE WELL OWNER.

SIGNATURE OF CERTIFIED WELL CONTRACTOR

DATE

PRINTED NAME OF PERSON CONSTRUCTING THE WELL

Submit the original to the Division of Water Quality within 30 days. Attn: Information Mgt.,
1617 Mall Service Center - Raleigh, NC 27699-1617 Phone No. (919) 733-7015 ext 568.

Form GW-1a
Rev. 7/05