

Granville - Vance District Health Department
Environmental Health
Well Construction Permit

1814


Owner/Applicant: Ernie Lombard Date: 4-17-16
Address or Location of Property: 9100 → Camellia Rd → (L) on Jones Wilson Rd
101 on (L) about 2 1/2 miles
Subdivision & Lot #: Winston Blvd - Lot 5 Septic Permit #: 8026
Zoning Permit #: R210 Environmental Health Specialist: Champion

This well permit is to locate and site the area that a private groundwater well may be established on the property listed above by the Environmental Health Specialists of Granville County. If one does not locate the well in the approved area and complete the well as specified by the 15A NCAC .02C rules, then permits may be revoked. At completion of drilling of the well, grout must be witnessed by EHS and a well log turned into Environmental Health.

Minimum Setbacks: (these are the main setbacks, but not all required setbacks)

Setback from property lines - 10 ft Setback from septic tank and drain field, including repair area - 100 ft
Setback from structural foundations - 25 ft Setback from ponds, lakes or other bodies of water - 50 ft

Site Sketch:

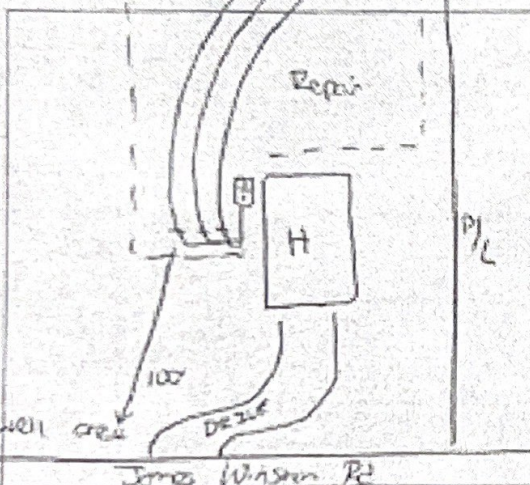


Conditions:

Authorized Agent: Carol Champion DEHS
Date: 4-17-16

Well Grout: (Circle or write in)
Witnessed: Yes or No EHS Agent: _____
Date: _____ Annular Space Open: Yes or No
Over reamed: Yes or No
Method: _____ Pump _____ Poured _____ Pressure
Depth Grouted: _____ ft
Well Log received: Yes or No (EHS to Attach to Permit)

As Built Drawing:

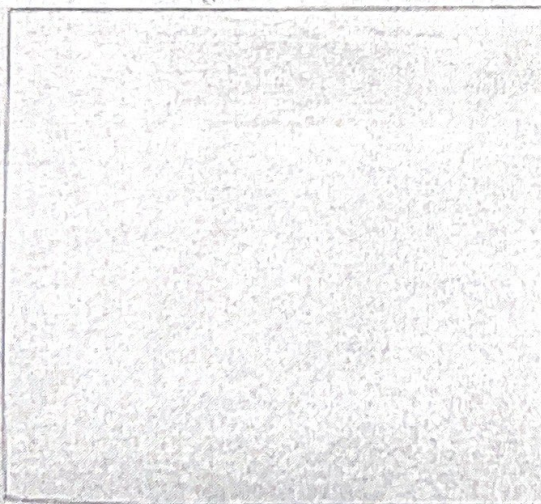

Well Final: (Place a check mark when finalized)
Seal Present and Intact: _____ Air Vent: _____
Hose Spigot: _____ Electrical Box: _____
Pump Installer Tag: _____ Well Installer Tag: _____
All holes sealed: _____ 12" above grade: _____
Comments: _____

Well Completion Permit: _____, EHS
Date Completed: _____

Water Samples Taken: Date: _____
EHS: _____ Results: _____
Retest: _____ Results: _____

Page 008000958293

Permit Number 2026/1814

✓ Construction Authorization

Ernest Lambert

Applicants Name

Winston Bluff - 12th 5

Subdivision - Section - Lot

Applicant Name
Cassidy "Corey" Champion 2016
Authorized State Agent

4-17-16

Date _____

System components represent approximate counts only. The contractor must flag the system prior to beginning the installation to insure that proper grade is maintained.

Total

2 bed 240sqft

1000 gpl septil ton

.30 CTAR


D-box

270 A combined trench

பெரிய கருத்து மீதம்

Rake trench
sidewalks

Table on
Concave

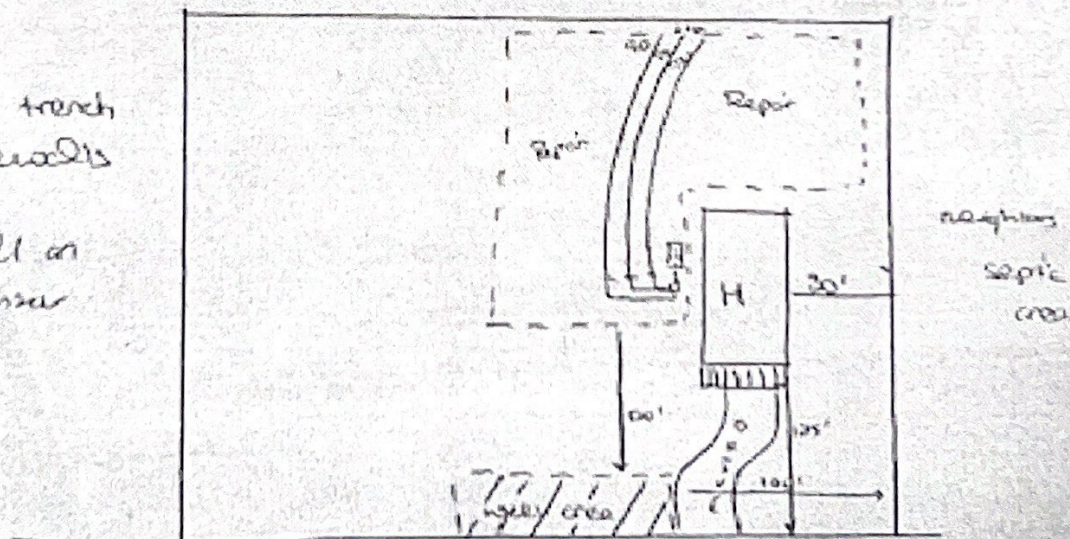

Jones Winston Rd

Signature _____

Date 4-17-16

PERMIT NUMBER 8626

GRANVILLE-VANCE DISTRICT HEALTH DEPARTMENT IMPROVEMENT AND OPERATION PERMITS 7P# 19210

COUNTY:	TAX NO.	TYPE OF ESTABLISHMENTS		
Granville	00800058222	RESIDENCE ☒	NUMBER OF BEDROOMS	NUMBER OF OCCUPANTS
	SR. NO.	BUSINESS ☐	2	now 4
APPLICANT:		OTHER ☐	WELL ☒	OTHER ☐
Ernest Lombert		Private	PUBLIC ☐	
APPLICANT'S NAME & ADDRESS		WATER SUPPLY	INITIAL INSTALLATION	REPAIR
PO Box 712		Private	11.0	11.0
Maple, N. 2738		TYPE OF WASTEWATER SYSTEM	DESIGN FLOW	
PROPERTY ADDRESS/LOCATION:			240	240
James Winston Rd		DESIGN FLOW	240	240
SUBDIVISION:		LEAK	.30	.30
Winston Bluff		ABSORPTION AREA	800 ft ²	800 ft ²
LOT NUMBER: 1st 5		TRENCH WIDTH	36"	36"
REFERENCE SKETCH (SEE PLAT FOR DETAILS)		TRENCH DEPTH	24"	24"
960 N → Cornwell → ① on		TRENCH SPACING	9' on center	9' on center
James Winston Rd → 1st on		TOTAL TRENCH LENGTH	270 ft	270 ft
① about 2 1/2 miles		NUMBER OF TRENCHES	3	3
- Pave trench shoulders		GRAVEL DEPTH	12"	12"
- Maintain center		TANK SIZE	1000 gal	1000 gal
		PUMP TANK SIZE	-	-
		DISTRIBUTION DEVICE	Distribution Box	D-box

"THIS PERMIT SHALL BE ACCOMPANIED BY A LAYOUT SHOWN ON A PLAT, INCLUDING SYSTEM REQUIREMENTS."

"THIS IMPROVEMENT PERMIT IS SUBJECT TO REVOCATION IF THE INTENDED USES CHANGE FROM THOSE SHOWN ON THE IMPROVEMENT PERMIT. CHANGES SHALL REQUIRE HEALTH DEPARTMENT APPROVAL."

PERMIT VALID FOR 5 YEARS
YES ☒ NO ☐

NO EXPIRATION
YES ☒ NO ☐

IMPROVEMENT PERMIT

DATE 4-17-16

FOR: Ernest Lombert

ISSUED BY: Cassady "Casey" Chapman REHS

CONSTRUCTION AUTHORIZATION FOR IMPROVEMENT PERMIT

Unless otherwise indicated, the same conditions above apply regarding system type, layout, location and installation requirements.
(The wastewater system cannot be installed until authorization is signed)

Comments: Follow site sketch

Date: 4-17-16 Environmental Health Specialist: *Cassady Chapman*

Construction Authorization Addendum: ☒ Yes ☐ No

OPERATION PERMIT

DATE:

SYSTEM INSTALLED BY:

ISSUED BY:

PERFORMANCE, MONITORING, MAINTENANCE AND OPERATION
AS REQUIRED BY RULE .1961