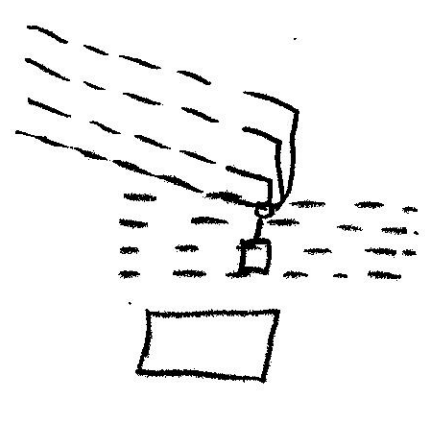


GRANVILLE - VANCE DISTRICT HEALTH DEPARTMENT
IMPROVEMENT AND OPERATION PERMITS

COUNTY: <i>Vance</i>	TAX NO. <i>0616 01026</i>	TYPE OF ESTABLISHMENT <i>GC P</i>			*THIS PERMIT SHALL BE ACCOMPANIED BY A LAYOUT SHOWN ON A PLAT, INCLUDING SYSTEM REQUIREMENTS. *THE IMPROVEMENTS PERMIT MUST BE ATTACHED TO A CONSTRUCTION AUTHORIZATION BEFORE OBTAINING BUILDING PERMIT OR OTHER CONSTRUCTION PERMITS AND BEFORE A WASTEWATER SYSTEM IS INSTALLED. *THIS IMPROVEMENT PERMIT IS SUBJECT TO REVOCATION IF THE INTENDED USE CHANGE FROM THOSE SHOWN ON THE IMPROVEMENT PERMIT. CHANGES SHALL REQUIRE HEALTH DEPARTMENT APPROVAL.
SR NO. <i>1001</i>		RESIDENCE ☒	NUMBER OF BEDROOMS: <i>4</i>	NUMBER OF OCCUPANTS: <i>2</i>	
OWNER: <i>William Stevenson</i>		BUSINESS ☐	OTHER ☐		
APPLICANT: <i>same</i>		WATER SUPPLY			
APPLICANT'S ADDRESS:		PUBLIC ☐	WELL ☒	OTHER ☐	
PROPERTY ADDRESS/LOCATION: <i>Warrinton Rd left at Cokerbury turn 175 Peebles</i>		TYPE OF WASTEWATER SYSTEM			
SUBDIVISION:		DESCRIPTION	INITIAL INSTALLATION	REPAIR	
LOT NUMBER: <i>2</i>		DESIGN FLOW:	<i>480</i>		
		LTAR:	<i>.35</i>		
REFERENCE SKETCH (SEE PLAT FOR DETAILS)		ABSORPTION AREA:	<i>1500'ft</i>		
		TRENCH WIDTH:	<i>3'</i>		
		TRENCH SPACING:	<i>9'</i>		
		TOTAL TRENCH LENGTH:	<i>500</i>		
		NUMBER OF TRENCHES:	<i>4 @ .5</i>		
		GRAVEL DEPTH:	<i>12"</i>		
		TANK SIZE:	<i>1000</i>		
		CONDITIONS:			
IMPROVEMENT PERMIT				DATE:	
FOR:					
ISSUED BY: <i>Walter J. Vaughn - KS</i>				<i>12-9-97</i>	
OPERATION PERMIT				DATE:	
SYSTEM INSTALLED BY: <i>David King</i>					
ISSUED BY: <i>W. Vaughn</i>				<i>12-22-98</i>	