

PERMIT NUMBER 7931

GRANVILLE-VANCE DISTRICT HEALTH DEPARTMENT IMPROVEMENT AND OPERATION PERMITS

COUNTY:	TAX NO.	TYPE OF ESTABLISHMENTS			*THIS PERMIT SHALL BE ACCOMPANIED BY A LAYOUT SHOWN ON A PLAT, INCLUDING SYSTEM REQUIREMENTS.
Granville	SR. NO.	RESIDENCE ☒	NUMBER OF BEDROOMS:	NUMBER OF OCCUPANTS:	
		BUSINESS ☐	3	max 6	
		OTHER ☐			
OWNER:		WATER SUPPLY	WELL ☒	OTHER ☐	*THIS IMPROVEMENT PERMIT IS SUBJECT TO REVOCATION IF THE INTENDED USES CHANGE FROM THOSE SHOWN ON THE IMPROVEMENT PERMIT. CHANGES SHALL REQUIRE HEALTH DEPARTMENT APPROVAL.
APPLICANT'S ADDRESS:		TYPE OF WASTEWATER SYSTEM	INITIAL INSTALLATION	REPAIR	
34 Franklin Lane			IIa	IIa	
Henderson NC 27537		DESIGN FLOW:	360	360	
PROPERTY ADDRESS/LOCATION:		LTAR:	30	30	
corner of large + Bowling		ABSORPTION AREA:	1200 ft ²	1200 ft ²	
SUBDIVISION:	Bowling Man	TRENCH WIDTH:	36"	36"	
LOT NUMBER:	7	TRENCH DEPTH:	18-22"	20"	
REFERENCE SKETCH (SEE PLAT FOR DETAILS)		TRENCH SPACING:	9' on center	9' on center	
		TOTAL TRENCH LENGTH:	400 ft	400 ft	
		NUMBER OF TRENCHES:	4	4	PERMIT VALID FOR: 5 YEARS YES ☒ NO ☐
		GRAVEL DEPTH:	12"	12"	
		TANK SIZE:	1000		NO EXPIRATION YES ☐ NO ☒
		PUMP TANK SIZE:	N/A		
		DISTRIBUTION DEVICE:	Distribution Box		

Maintain all setbacks

DO NOT INSTALL IN WET SOILS

***** IMPROVEMENT PERMIT DATE: 9-11-14 *****

FOR: Ralph Johnson
ISSUED BY: Cassandra "Casey" Chammin REHS

CONSTRUCTION AUTHORIZATION FOR IMPROVEMENT PERMIT#

Unless otherwise indicated, the same conditions above apply regarding system type, layout, location and installation requirements.
(The wastewater system cannot be installed until authorization is signed)

Comments: _____

Date: 9-11-14 Environmental Health Specialist: Carol Ann Construction Authorization Addendum ☐ Yes ☒ No

OPERATION PERMIT

DATE: 10-15-18

SYSTEM INSTALLED BY: Chris Milko
ISSUED BY: Adam Green

PERFORMANCE, MONITORING, MAINTENANCE AND OPERATION
AS REQUIRED BY RULE .1961

Granville-Vance District Health Department

Environmental Health

PIN _____

Final Sketch

Date 10-15-18

Ralph ; Johnson

Applicant's Name

7931

Permit No.

Bowling Mountain / 7

Subdivision/Lot Number ..


Physical Address: Corner of Bowling Mtn + Range

Chris Milko

System Installer

Duland Green

Authorized Signature

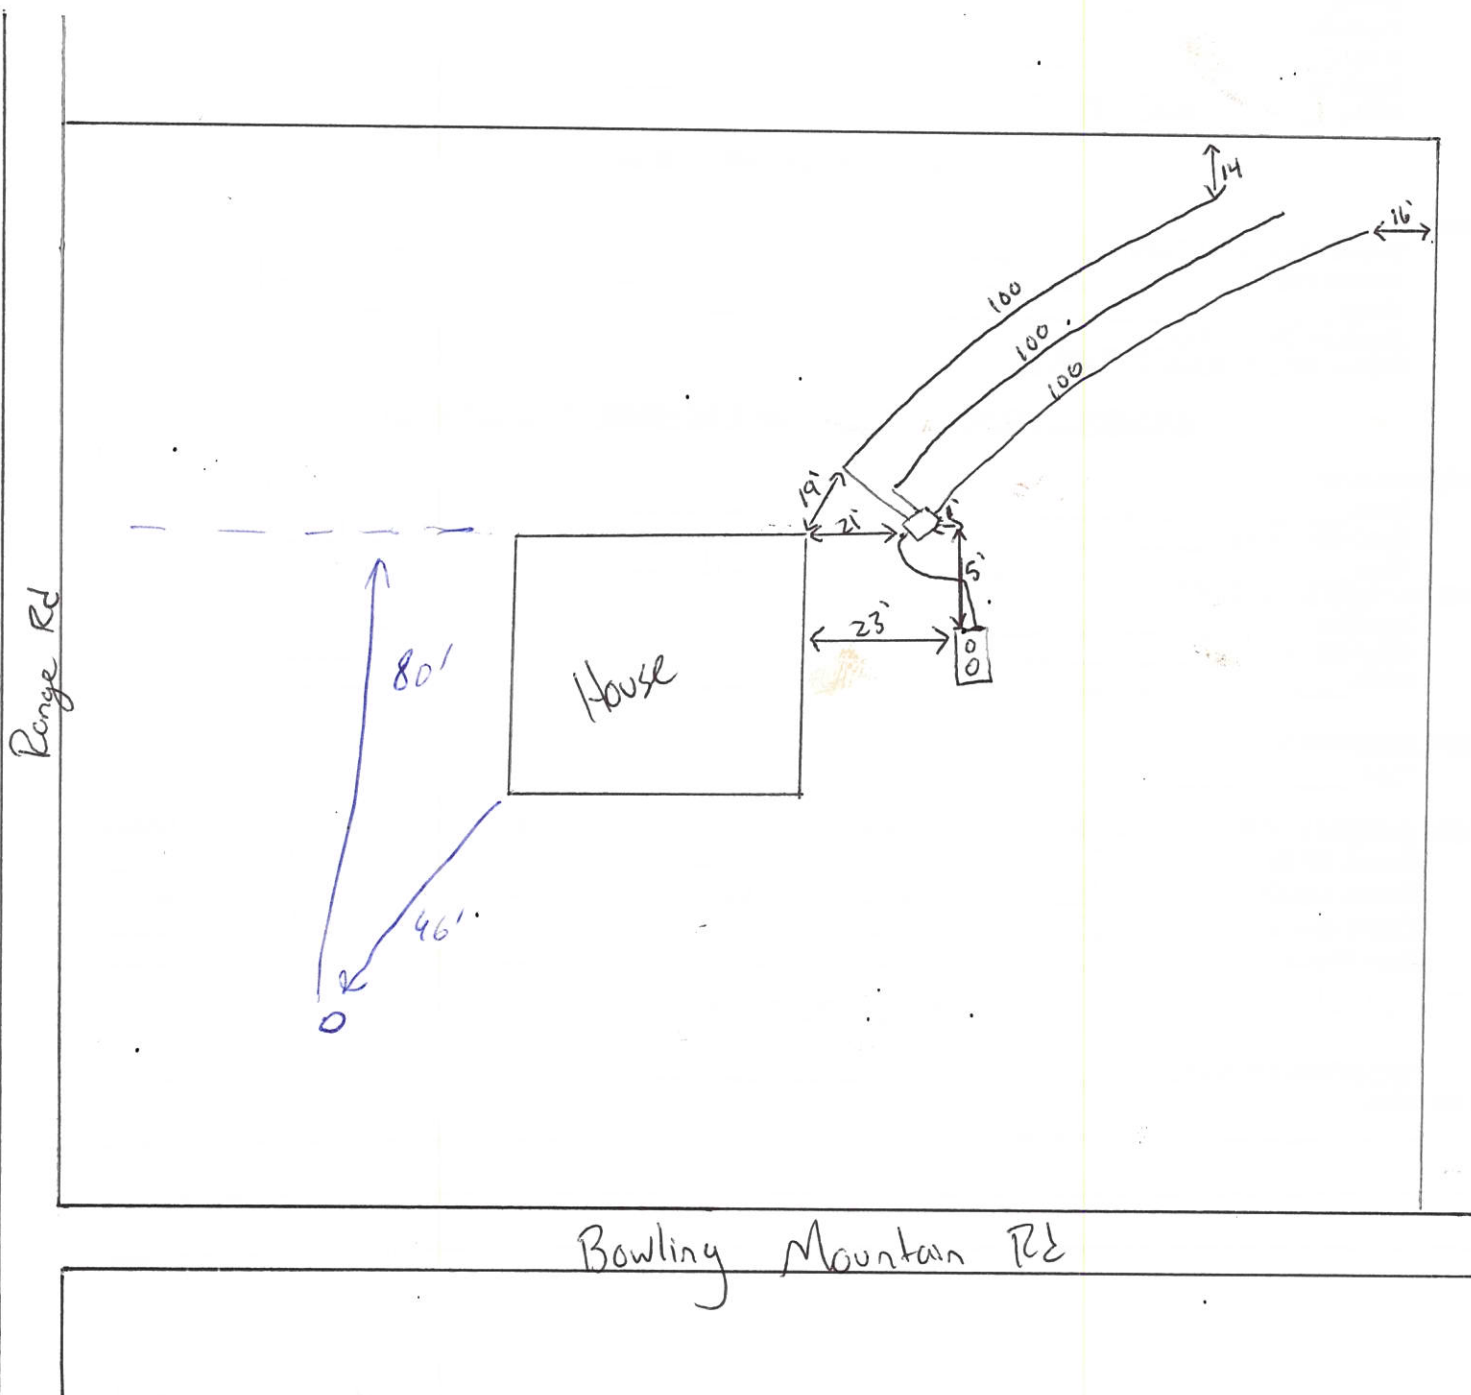

Granville - Vance District Health Department

Environmental Health

Well Construction Permit

2540

Owner/Applicant: Oscar Huskins
Address or Location of Property: _____

Date: 6/7/18


Subdivision & Lot #: Rowling Mt Lot 7 Septic Permit #: _____
Zoning Permit #: 18352 Environmental Health Specialist: W. Daryl

This well permit is to locate and site the area that a private groundwater well may be established on the property listed above by the Environmental Health Specialists of Granville County. If one does not locate the well in the approved area and complete the well as specified by the 15A NCAC .02C rules, then permits may be revoked. At completion of drilling of the well, grout must be witnessed by EHS and a well log turned into Environmental Health.

Minimum Setbacks: (these are the main setbacks, but not all required setbacks)

Setback from property lines – 10 ft Setback from septic tank and drain field, including repair area – 100 ft
Setback from structural foundations – 25 ft Setback from ponds, lakes or other bodies of water – 50 ft

Site Sketch:

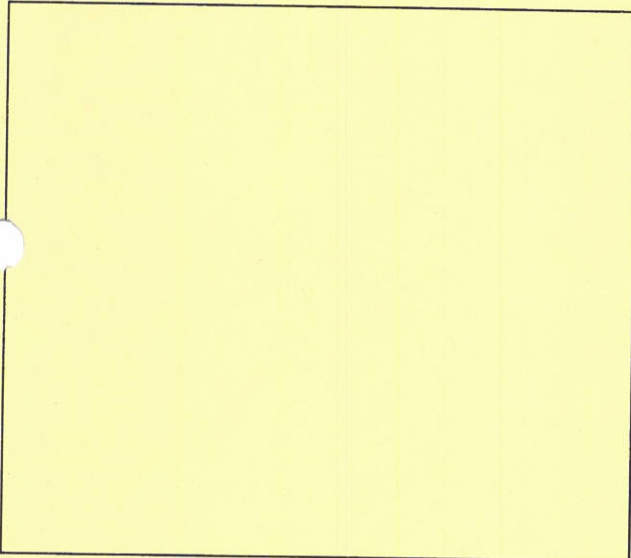


Conditions:

Authorized Agent: W. Daryl
Date: 6/7/18

1 Well Grout: (Circle or write in)

Witnessed: Yes or No EHS Agent: W. Daryl
Date: 12/21/18 Annular Space Open: Yes or No
Over reamed: Yes or No Depth Grouted: 204
Method: _____ Pump ✓ Poured _____ Pressure
Well Log received: Yes or No (EHS to Attach to Permit)
Driller Name: Southern Cert. # _____
Depth: 480 Casing Depth: 42 GPM: 2

As Built Drawing:

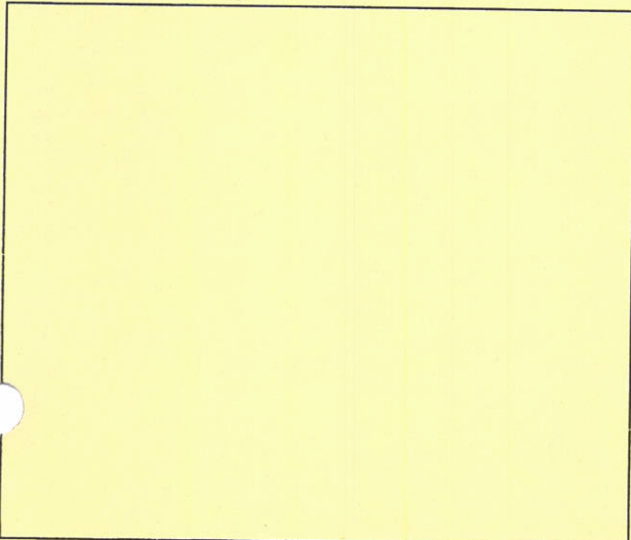

2 Well Final: (Place a check mark when finalized)

Seal Present and Intact: ✓ Air Vent: ✓
Hose Spigot: ✓ Electrical Box: ✓
Pump Installer Tag: ✓ Well Installer Tag: ✓
All holes sealed: ✓ 12" above grade: ✓

Comments:

3 Well Completion Permit: W. Daryl EHS
Date Completed: 1/30/19

4 Water Samples Taken: Date: _____
EHS: _____ Results: _____
Retest: _____ Results: _____