

9196030106

PERMIT NUMBER 8276GRANVILLE-VANCE DISTRICT HEALTH DEPARTMENT
IMPROVEMENT AND OPERATION PERMITS

EP# 18867

COUNTY:	TAX NO.	TYPE OF ESTABLISHMENTS			THIS PERMIT SHALL BE ACCOMPANIED BY A LAYOUT SHOWN ON A PLAT, INCLUDING SYSTEM REQUIREMENTS.
Granville	1811a 001711 3	RESIDENCE ☒	NUMBER OF BEDROOMS:	NUMBER OF OCCUPANTS:	
OWNER: Steven D. Hayes	SR. NO.	BUSINESS ☐	3	max 6	
APPLICANT'S ADDRESS: 78 Hayes Ct		OTHER ☐			
Fenton, NC 27575		WATER SUPPLY	WELL ☒	OTHER ☐	THIS IMPROVEMENT PERMIT IS SUBJECT TO REVOCATION IF THE INTENDED USES CHANGE FROM THOSE SHOWN ON THE IMPROVEMENT PERMIT. CHANGES SHALL REQUIRE HEALTH DEPARTMENT APPROVAL.
PROPERTY ADDRESS/LOCATION: 4527 Carson Lane		TYPE OF WASTEWATER SYSTEM	INITIAL INSTALLATION	REPAIR	
SUBDIVISION: Windsor		DESIGN FLOW:	3.0		
LOT NUMBER: 13		LIR:	1.30		
REFERENCE SKETCH (SEE PLAT FOR DETAILS)		ABSORPTION AREA:	1200 ft ²		PERMIT VALID FOR 5 YEARS YES ☒ NO ☐
- Do not install in wet soils		TRENCH WIDTH:	36"		
- Maintain setbacks		TRENCH DEPTH:	20-24"		
- Stay 15 ft from pool with septic.		TRENCH SPACING:	9' center		
		TOTAL TRENCH LENGTH:	400 ft gravel / 300 ft. acc		NO EXPIRATION YES ☐ NO ☒
		NUMBER OF TRENCHES:	4		
		GRAVEL DEPTH:	12" / accepted		
		TANK SIZE:	1200		
		PUMP TANK SIZE:	1200		
		DISTRIBUTION DEVICE:	pressure manifold		

IMPROVEMENT PERMIT

DATE: 8-22-15

FOR: Steven D. Hayes

ISSUED BY:

Cassandra "Cassie" Chapman PEHS

CONSTRUCTION AUTHORIZATION FOR IMPROVEMENT PERMIT#

Unless otherwise indicated, the same conditions above apply regarding system type, layout, location and installation requirements.
(The wastewater system cannot be installed until authorization is signed)

Comments: Follow site sketch

Date: 8-22-15

Environmental Health Specialist: [Signature]

Construction Authorization Addendum ☐ Yes ☒ No

OPERATION PERMIT

DATE: 10/23/15

SYSTEM INSTALLED BY: [Signature]

ISSUED BY: [Signature]

PERFORMANCE, MONITORING, MAINTENANCE AND OPERATION
AS REQUIRED BY RULE .1961

Granville - Vance District Health Department
Environmental Health


Final Sketch

Pin 184600174863

Windsor 13
Subdivision - Section - Lot

Physical Address: 4527 Carson Lane

System design and details as installed.

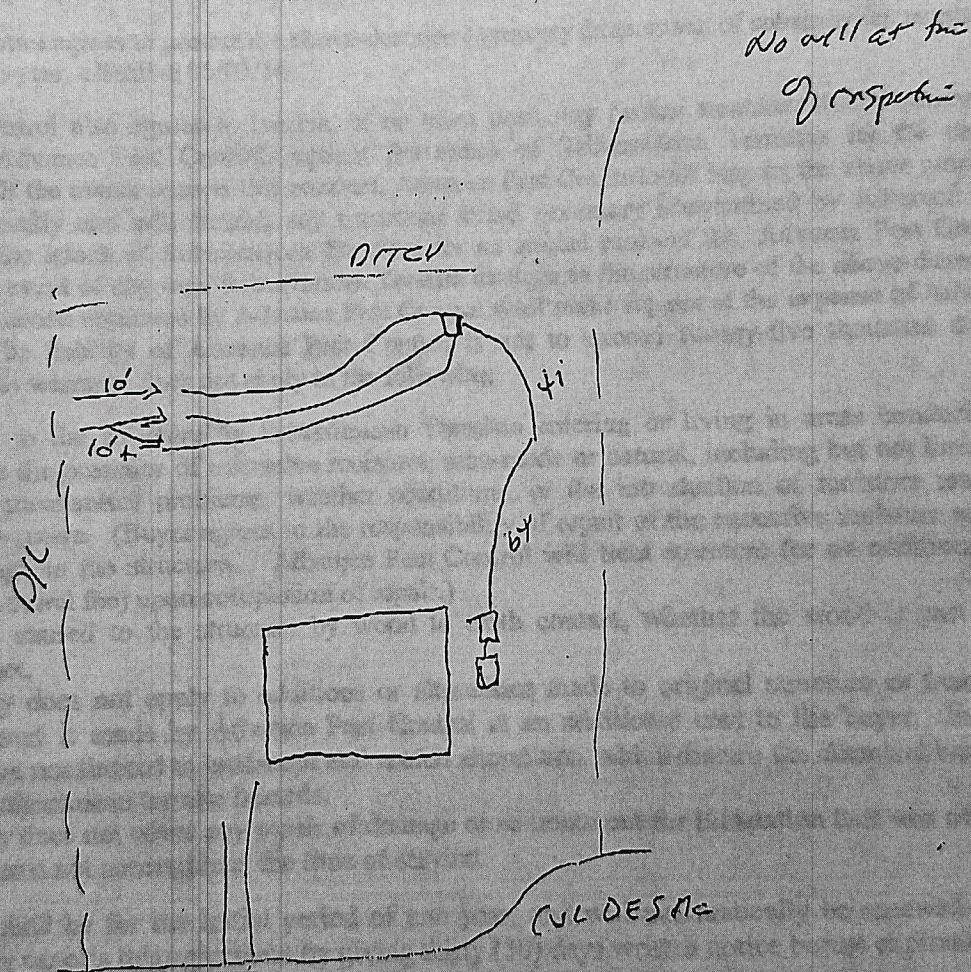

Ch. 11A
Authorized Signature

10/23/15
Date