

GRANVILLE VANCE

public health

OPERATION PERMIT

Vance County Health Dept
Environmental Health
115 Charles Rollins Road
Henderson, NC 27536

Phone: (252) 492-5263 Fax: (252) 492-2361

For Office Use Only

*CDP File Number 380185 - 1

County ID Number: 0529 02008

Evaluated For: REPAIR

Property Owner: Ryan Balok

Address: 4522 Holloman Rd

Road #:

City: Durham

State/Zip: NC/ 27703

Phone #: (919) 748-2192

Township:

Subdivision:

Phase : NEW

Lot:

Structure: SINGLE FAMILY

of Bedrooms: 3

of People: 6

Water Supply: EXISTING WELL

Saprolite System?: ☐ Yes ☒ No

Pump Required?: ☐ Yes ☒ No

Design Flow: 360

System Classification/Description: TYPE III G. OTHER
NON-CONV. TRENCH SYSTEMS

Installer: KT MOORE SEPTIC SERVICE

Certification #: 12611

Specific System EZFLOW EZ 1203H-GEO

Installed:

STB: 789

PT:

Comments:

Septic Tank Date: 06/22/2022

Pump Tank Date: _____

This system has been installed in compliance with applicable NC General Statutes, Rules for Sewage Treatment and Disposal, and all conditions of the Improvement Permit and Construction Authorization.

PERMIT CONDITIONS:

I. Performance: System shall perform in accordance with Rule .1961.

II. Monitoring: As required by Rule .1961.

III. Maintenance: Ground absorption sewage treatment and disposal systems shall be checked, and the contents of the septic tank removed, periodically from all compartments, to ensure proper operation of the system. The contents shall be pumped whenever the solids level is found to be more than 1/3 of the liquid depth in any compartment.

Other:

Subsurface Operator Required: ☐ Yes ☒ No

If yes, see attached sheet for additional operation conditions, maintenance and reporting.

Operation:

Other:

Authorized State Agent: Hedrick, Chris



Date of Issue: 10/06/2022

Owner/Applicant: _____

Construction Authorization

Vance County Health Dept
Environmental Health
115 Charles Rollins Road
Henderson, NC 27536

Phone: (252) 492-5263 Fax: (252) 492-2361

For Office Use Only

*CDP File Number: 380185 - 1

County ID Number: 0529 02008

Evaluated For: REPAIR

PERMIT VALID UNTIL: 10/03/2027

☐ Open Pump System Sheet

Applicant: Ryan Balok
Address: 4522 Holloman Rd
City: Durham
State/Zip: NC 27703
Phone #: cell : (919) 748-2192

Property Owner: Ryan Balok
Address: 4522 Holloman Rd
City: Durham
State/Zip: NC 27703
Phone #: cell : (919) 748-2192

Property Location & Site Information

Address/Road #: 55 Daniel Harris Rd
Henderson, NC 27537

Subdivision:

Phase: NEW Lot:

Directions:

Structure: SINGLE FAMILY

See attachment

of Bedrooms: 3

of People: 6

*Water Supply: EXISTING WELL

System Specifications

*Site Classification:

Minimum Trench Depth: _____ Inches

Design Flow: 360

Maximum Trench Depth: 24 Inches

Soil Application Rate: _____

Minimum Soil Cover: _____ Inches

*System Classification/Description:

TYPE III G. OTHER NON-CONV. TRENCH SYSTEMS

Maximum Soil Cover: _____ Inches

*Proposed System:

25% REDUCTION

*Distribution Type: GRAVITY - PARALLEL (eq. d-box)

Nitrification Field: 900 Sq. ft.

Septic Tank: 1,000 Gallons

No. Drain Lines: 2

Pump Required: ☐ Yes ☒ No ☐ May Be Required

Total Trench Length: 300 ft.

☐ Inches O.C.

Pump Tank: _____ Gallons

☒ Feet O.C.

Trench Spacing: 9 - _____

☐ Inches

Grease Trap: _____ Gallons

Trench Width: 3 - _____

☒ Feet

Septic Tank Installer

Aggregate Depth: _____ inches

Grade Level Required: ☐ I ☒ II ☐ III ☐ IV

The issuance of this permit by the Health Department in no way guarantees the issuance of other permits. The permit holder is responsible for checking with appropriate governing bodies in meeting their requirements.

*Permit Conditions:

CONTRACTOR TO ESTABLISH AND FOLLOW CONTOUR. REPLACE TANK AND RAISE PLUMBING

The Authorization for Wastewater System Construction shall be valid for a period equal to the period of validity of the Improvement Permit and may be issued at the same time the Improvement Permit issued (NCGS 130A-336(b)). If the installation has not been completed during the period of validity of the Construction Permit, the information submitted in the application for a permit or Construction Authorization shall become invalid, and may be suspended or revoked (.1937(g)). The person owning or controlling the system shall be responsible for assuring compliance with the laws, rules, and permit conditions regarding system location, installation, operation, maintenance, monitoring, reporting

Authorized State Agent: Hedrick, Chris

Date of Issue: 10/03/2022

☐ Hand Drawing☐ Import Drawing

Site Plan/Drawing attached.

Total Time : (HH:MM) _____

Granville – Vance District Health Department
Environmental Health


Final Sketch

Pin 3801185

Subdivision – Section – Lot

Physical Address: 55 Daniel Harris Rd

System design and details as installed. *Easy Flow*

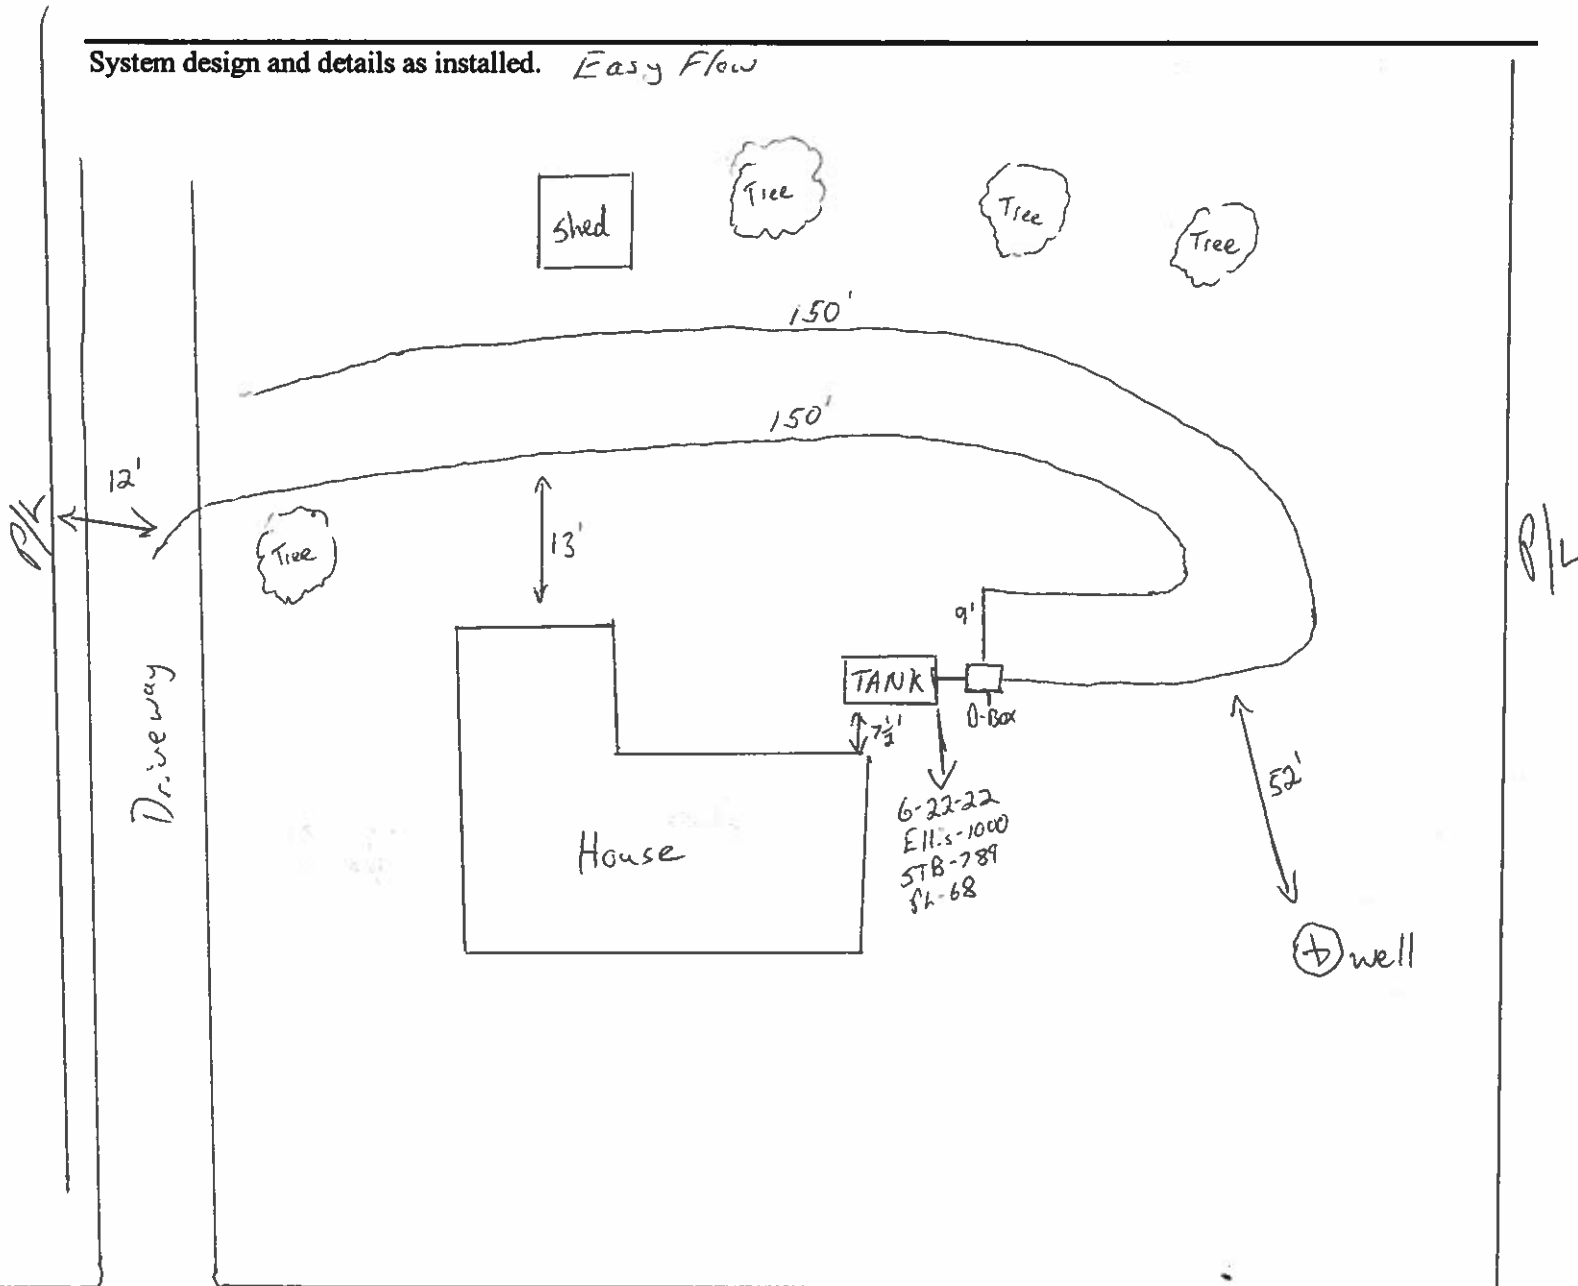

Daniel Harris Rd

[Signature]

Authorized Signature

[Signature]

10-6-22

Date