

PERMIT NUMBER 9140

GRANVILLE-VANCE DISTRICT HEALTH DEPARTMENT IMPROVEMENT AND OPERATION PERMITS

COUNTY: <u>GRANVILLE</u>	TAX NO. <u>182400121237</u>	TYPE OF ESTABLISHMENTS			*THIS PERMIT SHALL BE ACCOMPANIED BY A LAYOUT SHOWN ON A PLAT, INCLUDING SYSTEM REQUIREMENTS. *THIS IMPROVEMENT PERMIT IS SUBJECT TO REVOCATION IF THE INTENDED USES CHANGE FROM THOSE SHOWN ON THE IMPROVEMENT PERMIT. CHANGES SHALL REQUIRE HEALTH DEPARTMENT APPROVAL.
	SR. NO.	RESIDENCE ☒ BUSINESS ☐ OTHER ☐	NUMBER OF BEDROOMS: <u>4</u>	NUMBER OF OCCUPANTS: <u>8 MAX</u>	
APPLICANT: <u>WYNN CONST.</u>	WATER SUPPLY <u>PRIVATE</u>	WELL ☒ PUBLIC ☐	OTHER ☐	PERMIT VALID FOR: 5 YEARS <u>YES</u> NO NO EXPIRATION YES <u>NO</u>	
APPLICANT'S NAME & ADDRESS: <u>2550 CAPITAL DRIVE STE. 105 CREEDEMOLING 27522</u>	TYPE OF WASTEWATER SYSTEM	INITIAL INSTALLATION	REPAIR		
PROPERTY ADDRESS/LOCATION: <u>BUTTERFLY CIRCLE</u>	DESIGN FLOW:	<u>480 GPD</u>	<u>SAPROLITE SYSTEM</u>		
	LTAR:	<u>0.3 GPD/FT²</u>			
SUBDIVISION: <u>CHESLEIGH</u>	ABSORPTION AREA:	<u>1200 FT²</u>			
LOT NUMBER: <u>119</u>	TRENCH WIDTH:	<u>3'</u>			
REFERENCE SKETCH (SEE PLAT FOR DETAILS) * DO NOT INSTALL/CALL FOR INSPECTION IN WET CONDITIONS * MAINTAIN ALL SETBACKS * SYSTEM FLAGGED IN FIELD	TRENCH DEPTH:	<u>22-24"</u>			
	TRENCH SPACING:	<u>9' O.C.</u>			
	TOTAL TRENCH LENGTH:	<u>400' APPROX</u>			
	NUMBER OF TRENCHES:	<u>1 (SEE PLAT)</u>			
	GRAVEL DEPTH:	<u>N/A</u>			
	TANK SIZE:	<u>1200 GALLON</u>			
	PUMP TANK SIZE:	<u>1200 GALLON</u>			
	DISTRIBUTION DEVICE:	<u>8 HOLE 11" BOX</u>			

IMPROVEMENT PERMIT

DATE: 6-27-17

FOR: WYNN CONST.

ISSUED BY: Will Buller

CONSTRUCTION AUTHORIZATION FOR IMPROVEMENT PERMIT# 9140

Unless otherwise indicated, the same conditions above apply regarding system type, layout, location and installation requirements.
(The wastewater system cannot be installed until authorization is signed)

Comments: CONTRACTOR TO ESTABLISH & FOLLOW CONTOUR

Date: 6-27-17

Environmental Health Specialist: Will Buller

Construction Authorization Addendum ☒ Yes ☐ No

OPERATION PERMIT

DATE: 8-30-17 Tank & Wess (WTS) / 10-8-17
PP (WTS)

SYSTEM INSTALLED BY: Blackley

ISSUED BY: Will Buller

PERFORMANCE, MONITORING, MAINTENANCE AND OPERATION
AS REQUIRED BY RULE .1961

Granville - Vance District Health Department
Environmental Health

Final Sketch

Pin 182400121237

☒ Improvement Permit

☒ Construction Authorization

WYNN CONST.
Applicant's Name

Permit No. 9140


CHESLEIGH 119
Subdivision - Section - Lot

Physical Address: BUTTERFLY CIRCLE

BLACKLEY
System Installer

8-30-17
Date

System design and details as installed.

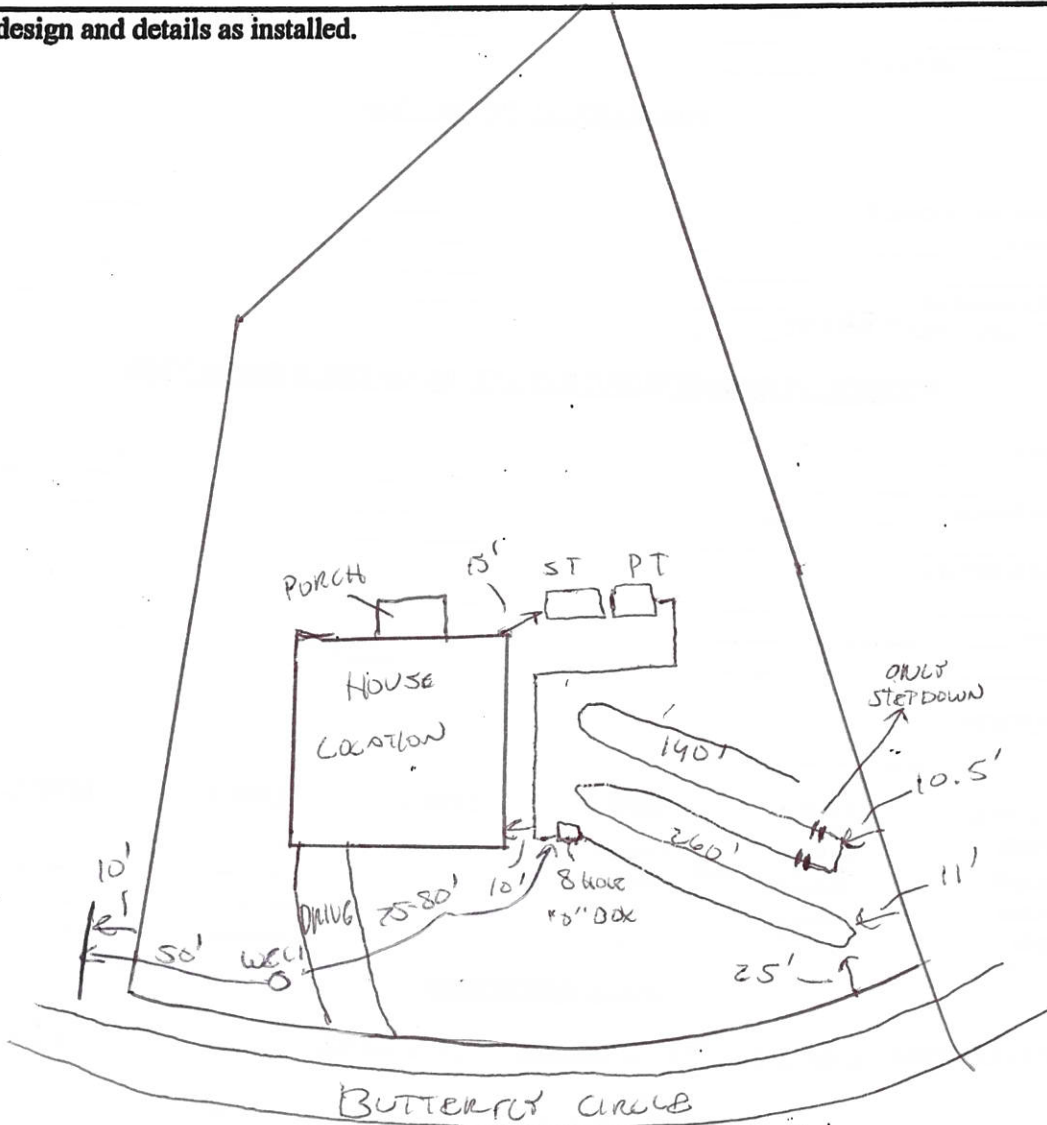

Will Blackley
Authorized Signature

8-30-17
Date



RESIDENTIAL WELL CONSTRUCTION RECORD

North Carolina Department of Environment and Natural Resources - Division of Water Quality

WELL CONTRACTOR CERTIFICATION # 3104

1. WELL CONTRACTOR:

Van Elliott

Well Contractor (Individual) Name

SOUTHERN WELL DRILLING

Well Contractor Company Name

STREET ADDRESS 1530 Beaver Dam Road

Creedmoor NC 27522

City or Town State Zip Code

(919) 603-7165

Area code - Phone number

2. WELL INFORMATION:

SITE WELL ID # (if applicable) 2112

STATE WELL PERMIT # (if applicable)

DWQ or OTHER PERMIT # (if applicable)

WELL USE (Check Applicable Box): Residential Water Supply ☐

DATE DRILLED 9-13-17

TIME COMPLETED AM ☐ PM ☐

3. WELL LOCATION:

CITY: Creedmoor COUNTY: Granville

Chesleigh Lot 119

(Street Name, Number, Community, Subdivision, Lot No., Parcel, Zip Code)

TOPOGRAPHIC / LAND SETTING:

☐ Slope ☐ Valley ☒ Flat ☐ Ridge ☐ Other

(check appropriate box)

LATITUDE 3

LONGITUDE

May be in degrees, minutes, seconds or in a decimal format

Latitude/longitude source: ☐ GPS ☐ Topographic map

(location of well must be shown on a USGS topo map and attached to this form if not using GPS)

4. WELL OWNER

OWNER'S NAME Wynn Const

STREET ADDRESS

Creedmoor

City or Town State Zip Code

()

Area code - Phone number

5. WELL DETAILS:

a. TOTAL DEPTH: 200

b. DOES WELL REPLACE EXISTING WELL? YES ☐ NO ☒

c. WATER LEVEL Below Top of Casing: 20 FT.
(Use "+" if Above Top of Casing)

d. TOP OF CASING IS 41 FT. Above Land Surface*
*Top of casing terminated at/or below land surface may require a variance in accordance with 15A NCAC 2C .0118.

e. YIELD (gpm): 20 METHOD OF TEST Air

f. DISINFECTION: Type Amount

g. WATER ZONES (depth):

From 180 To From To

From To From To

From To From To

6. CASING:

Depth Diameter Thickness/Weight Material
From 41 To 80 Ft. 6 PVC

From To Ft.

From To Ft.

7. GROUT:

Depth Material Method

From 0 To 20 Ft. Beninite Poured

From To Ft.

From To Ft.

8. SCREEN:

Depth Diameter Slot Size Material

From To Ft. in. in.

From To Ft. in. in.

From To Ft. in. in.

9. SAND/GRAVEL PACK:

Depth Size Material

From To Ft.

From To Ft.

From To Ft.

10. DRILLING LOG

From To Formation Description

11. REMARKS:

I DO HEREBY CERTIFY THAT THIS WELL WAS CONSTRUCTED IN ACCORDANCE WITH 15A NCAC 2C, WELL CONSTRUCTION STANDARDS, AND THAT A COPY OF THIS RECORD HAS BEEN PROVIDED TO THE WELL OWNER.

SIGNATURE OF CERTIFIED WELL CONTRACTOR

DATE

PRINTED NAME OF PERSON CONSTRUCTING THE WELL

Submit the original to the Division of Water Quality within 30 days. Attn: Information Mgt.,
1617 Mail Service Center - Raleigh, NC 27699-1617 Phone No. (919) 733-7015 ext 568.

Form GW-1a
Rev. 7/05