

Granville - Vance District Health Department

00385

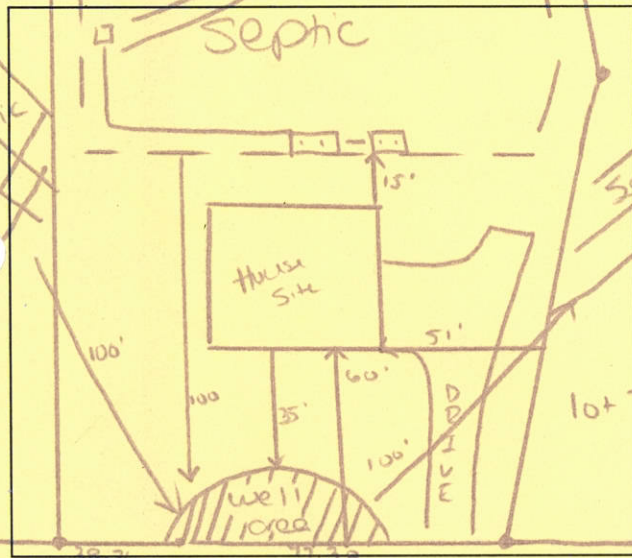
Environmental Health
Well Construction Permit

Owner/Applicant: Summer Construction Date: 10-11-10
 Address or Location of Property: 96 S → Horseshoe Rd → (L) on Lawrence Rd → (L) on
Bruce Garner Rd → (L) into Preserve → (L) on Garner Terrace → (L) on old Sall → (L) on
 Subdivision & Lot #: Preserve @ SC - lot 70 Septic Permit #: 6943 Cottonfield Ct
 Zoning Permit #: 2P # 16873 Environmental Health Specialist: Champion lot on (L)

This well permit is to locate and site the area that a private groundwater well may be established on the property listed above by the Environmental Health Specialists of Granville County. If one does not locate the well in the approved area and complete the well as specified by the 15A NCAC .02C rules, then permits may be revoked. At completion of drilling of the well, grout must be witnessed by EHS and a well log turned into Environmental Health.

Minimum Setbacks: (these are the main setbacks, but not all required setbacks)

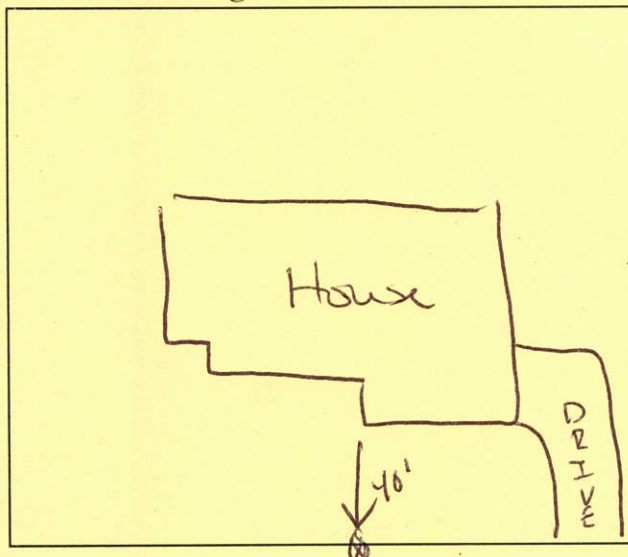
Setback from property lines – 10 ft Setback from septic tank and drain field, including repair area – 100 ft
 Setback from structural foundations – 25 ft Setback from ponds, lakes or other bodies of water – 50 ft

Site Sketch:**Conditions:**

Call for well site if needed.
 Authorized Agent: Cassidy Champion EHS
 Date: 10-11-10

1 Well Grout: (Circle or write in)

Witnessed: Yes or No EHS Agent: Champion
 Date: 1-28-11 Annular Space Open: Yes or No
 Over reamed: Yes or No Depth Grouted: 20'
 Method: Pump ☒ Poured Pressure
 Well Log received: Yes or No (EHS to Attach to Permit)
 Driller Name: Southern Cert. #
 Depth: 280' Casing Depth: 83' GPM: 10

As Built Drawing:**# 2 Well Final: (Place a check mark when finalized)**

Seal Present and Intact: ☒ Air Vent: ☒
 Hose Spigot: ☒ Electrical Box: ☒
 Pump Installer Tag: ☒ Well Installer Tag: ☒
 All holes sealed: ☒ 12" above grade: ☒
 Comments: Jenks 3/4 HP
Pump depth 190'

3 Well Completion Permit: David Cumber EHS
 Date Completed: 4-4-2011

4 Water Samples Taken: Date: 4-4-2011
 EHS: DC Results: good
 Retest: Results: