

PERMIT NUMBER 06943

GRANVILLE-VANCE DISTRICT HEALTH DEPARTMENT IMPROVEMENT AND OPERATION PERMITS

COUNTY:	TAX NO.	TYPE OF ESTABLISHMENTS			*THIS PERMIT SHALL BE ACCOMPANIED BY A LAYOUT SHOWN ON A PLAT, INCLUDING SYSTEM REQUIREMENTS.
OWNER: Summer Construction	SR. NO.	RESIDENCE ☒ BUSINESS ☐ OTHER ☐	NUMBER OF BEDROOMS:	NUMBER OF OCCUPANTS:	
	APPLICANT'S ADDRESS:	WATER SUPPLY	WELL ☒ PUBLIC ☐	OTHER ☐	
	PROPERTY ADDRESS/LOCATION:	TYPE OF WASTEWATER SYSTEM	INITIAL INSTALLATION	REPAIR	
SUBDIVISION:	DESIGN FLOW:	LTAR:	ABSORPTION AREA:	TRENCH WIDTH:	*THIS IMPROVEMENT PERMIT IS SUBJECT TO REVOCATION IF THE INTENDED USES CHANGE FROM THOSE SHOWN ON THE IMPROVEMENT PERMIT. CHANGES SHALL REQUIRE HEALTH DEPARTMENT APPROVAL.
LOT NUMBER:	TRENCH DEPTH:	TRENCH SPACING:	TOTAL TRENCH LENGTH:	NUMBER OF TRENCHES:	
REFERENCE SKETCH (SEE PLAT FOR DETAILS)	GRAVEL DEPTH:	TANK SIZE:	PUMP TANK SIZE:	DISTRIBUTION DEVICE:	

PERMIT VALID FOR: 5 YEARS
YES ☒ NO ☐

NO EXPIRATION
YES ☐ NO ☒

IMPROVEMENT PERMIT

DATE: 10-11-10

FOR: Summer Construction

ISSUED BY: Cassandra "Casey" Champion, REHS

CONSTRUCTION AUTHORIZATION FOR IMPROVEMENT PERMIT# 06943

Unless otherwise indicated, the same conditions above apply regarding system type, layout, location and installation requirements.
(The wastewater system cannot be installed until authorization is signed)

Comments: Follow Site Sketch

Date: 10-11-10 Environmental Health Specialist: Casey Champion, REHS

Construction Authorization Addendum ☐ Yes ☒ No

OPERATION PERMIT

DATE: 2-23-11 / 4-4-2011

SYSTEM INSTALLED BY: 4" Single Pump Tank

ISSUED BY: [Signature]

PERFORMANCE, MONITORING, MAINTENANCE AND OPERATION
AS REQUIRED BY RULE .1961

Granville - Vance District Health Department
Environmental Health

Pin 182500205825

Permit Number 6943

☒ Improvement Permit

☒ Construction Authorization

Final Sketch

Sumner Construction
Applicants Name

The Preserve #70
Subdivision - Section - Lot

Physical Address: Cotton Field Court

Triangle Pump & Tank
System Installer

2-23-11 / 4-4-2011
Drainfield Date

System design and details as installed.

Septic Tank Information:

Date: 10-29-10

Manufacture: Mills-1000gal

ID #: 513-858

Pump Tank Information:

Date: 11-12-10

Manufacturer: Mills-1000gal

ID #: PT

Distribution Box

Pressure Manifold X

Serial Distribution


Type of Facility: House

Number of Bedrooms: 3

Type of System: pump → chambers

Infiltrator: (82 panels)
'Quick-4' total
panels

2.5-head pressure
Zoeller N-152
pump
STE Rhombus
control panel

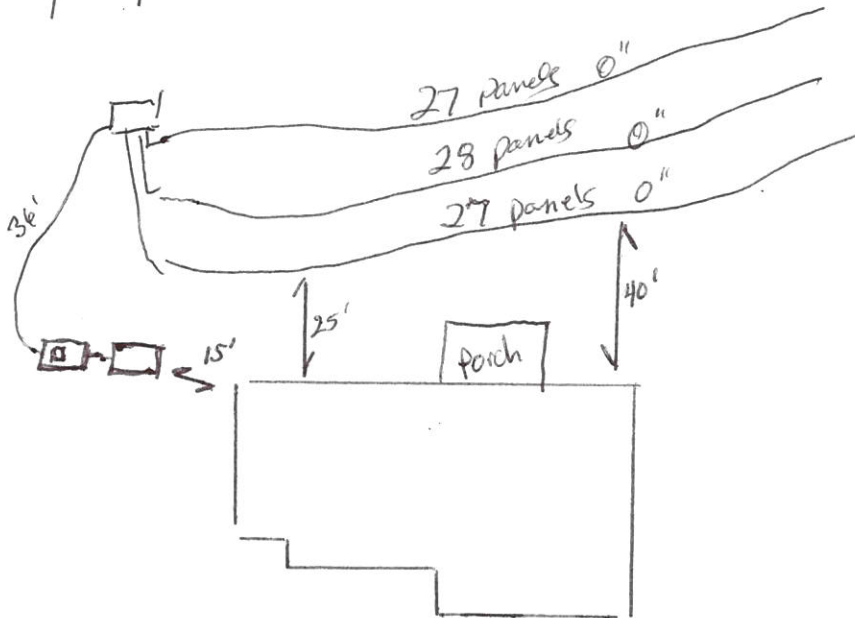

David C. Cline
Authorized Signature

Drainfield
2-23-11 / 4-4-2011
DC Date